IREDELL COUNTY HEALTH DEPARTMENT

Statesville Phone TR 3-7271 Mooresville Phone NO 3-1271

PERMIT TO INSTALL SEPTIC TANK

Permit NO._____ Permit Date DEC 16 1960

Owner W. L BALLARD Address R.F.D STATESVILLE, N.C.

Installed By SONNY SHERRILL Address STATESVILLE, N.C.


Location of Property OUT BATTLE SHOALS RD. 6½ MILES ON RIGHT - PINK FRAME - JUST BEFORE NEW REST HOME

Tank	Capacity	Length of Lines	Fixtures
Block ( )	800 ( )	150' ( )	No. of Baths ( )
Precast ( )	900 ( )	175' ( )	Dishwasher ( )
	1000 (✓ 4'X8'X7')	200' ( )	Garbage Grdr. ( )
	1100 ( )	225' (✓)	Auto-Washer ( )
	1200 ( )	250' ( )	Other_____
	Other_____	Other_____	

NOTIFY HEALTH DEPARTMENT AT LEAST EIGHT HOURS BEFORE TANK IS TO BE INSPECTED.

Final Inspection DEC 16 1960 Approved (✓) Disapproved ( )

Remarks Ditch 7' wide. Store 2"- 1"x4" board Poor log out!

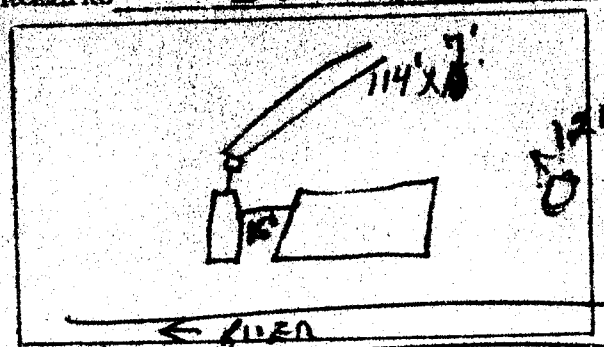

Sketch of Installation

Rufus A. Thomas

Sanitarian