IREDELL COUNTY HEALTH DEPARTMENT

THIS PERMIT REPLACES PREVIOUS ISSUED 9-4-03 CF

STATESVILLE 704-878-5305 MOORESVILLE 704-664-5281

(1) IMPROVEMENT PERMIT / AUTHORIZATION TO CONSTRUCT / OPERATION PERMIT / EXISTING SYSTEM INSPECTION

PERMIT# 115442 PIN# 4712-97-~~5226~~6009 9945 DATE 3-15-04

OWNER OR CONTRACTOR JOHN KIKER PHONE: Business 704-363-8778 Home

ADDRESS 141 SUNSHINE DRIVE MOORESVILLE, NC 28115

LOCATION BUFFALO SHOALS ROAD S/W TR COMET TRAIL, AT CUL-DE-SAC ON RIGHT

SUBDIVISION BADGER CREEK BLOCK / SECTION LOT 19 LOT AREA 5.29 ACRES SITE CLASS. PS DESIGN FLOW 360 L.T.A.R. 0.30 GPD/FT²

Septic Tank: 1000 Gallons; STB 794 Date 6-24-04
Pump Tank: Gallons; PT Date
Pump Make: Model Serial No.
Nitrification Field: No Fields 1 Square Feet 1200 Linear Feet 400
No Lines FIVE Trench Width 36" Max Trench Bottom Depth 30" Gravel Depth 12"

☑ New System ☐ Repair System Type: I, II, III, IV, V, VI
System Description: CONVENTIONAL, GRAVITY
Repair System Description: CONVENTIONAL, GRAVITY
Maintenance Agreement Required: ☐ Yes ☑ No


☑ House/Mod. Home No. Bedrooms 3
☐ Mobile Home No. Bathrooms 2
☐ Business No. Employees
☐ Other
☐ Slab ☑ Crawl Space ☐ Basement w/plumbing ☐ Basement wo/plumbing

Water Supply: ☑ Individual ☐ Public ☐ Community
WELL

Comments:/Conditions: ① KEEP SYSTEM MINIMUM 100' FROM WELL
② INSTALL LINES ON CONTOUR, NO DEEPER THAN 30".

Comments:/Conditions: ZABEL FILTER & MANIFOLD
SYSTEM INSTALLED AS FLAGGED & DRAWN
POOL NOT INSTALLED AT TIME OF CHECK

INITIAL SITE SKETCH

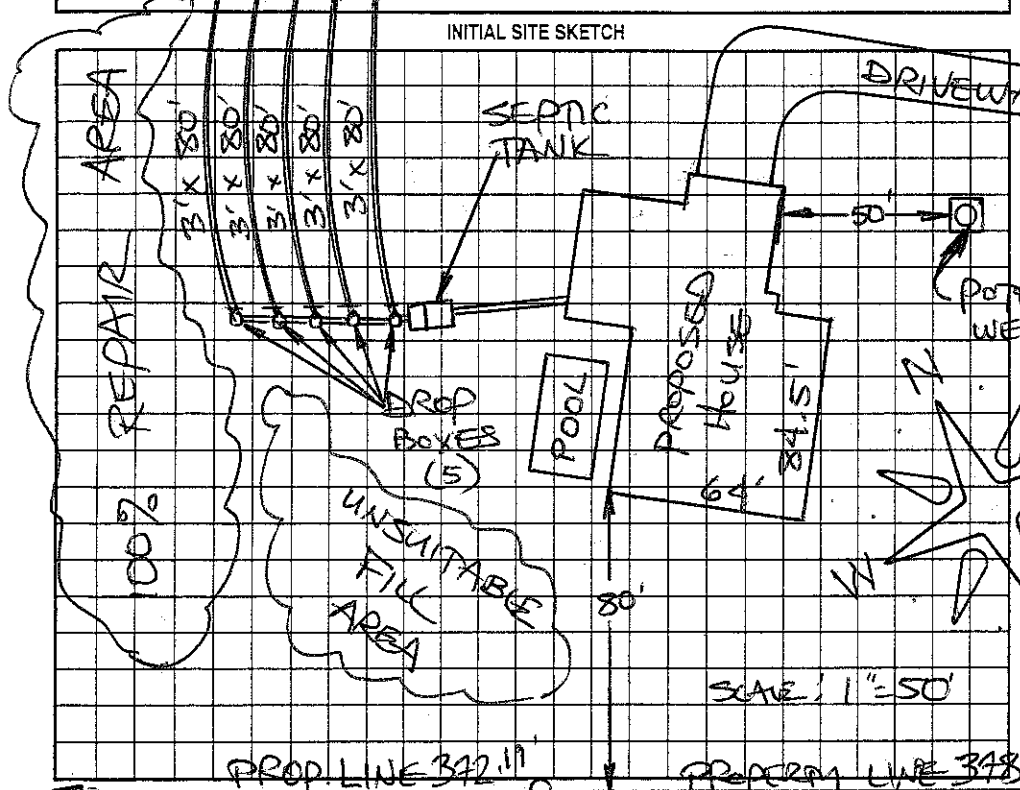

AS BUILT SKETCH

Permit can be suspended or revoked if any false information is supplied toward securing the permit/any unauthorized changes are made to the site/any unauthorized changes are made in the installation of the system. Improvement Permit with plat valid without expiration. Improvement Permit with site plan valid for sixty months. Authorization to Construct is valid for a period equal to that of Improvement Permit – not to exceed sixty months.

Signed: John K Kiker date 3/15/04

Improvement Permit by: STEVE HEDRICK date 3-15-04

Authorization to Construct by: STEVE HEDRICK date 3-15-04

Installed by: BW Christenbury

Operation Permit by: [signature] RS date 3-26-04

Existing System Inspection by: date

HEALTH DEPT. COPY: WHITE OWNER COPY (FINAL): YELLOW OWNER COPY (INITIAL): PINK