IREDELL COUNTY HEALTH DEPARTMENT

(SEPTIC TANK) IMPROVEMENTS PERMIT AND CERTIFICATE OF COMPLETION
(Ground Absorption Sewage Disposal System -- G. S. Chapter 130-Article 13C)

OWNER OR CONTRACTOR GRIER BUSTLE DATE 6-6-90 PERMIT NO.

PHONE: Business Home

LOCATION Lewis Ferry Rd. off old mtn. Rd. - 5th house on R.

SUBDIVISION NAME S. R. No.

LOT NO. SECTION OR BLOCK NO.

House (✓) Mobile Home ( ) Business ( ) Other Repair.

No. Bedrooms No. Bathrooms

Garbage Disposal Unit	Yes ( )	No ( )
Auto. Dishwasher	Yes ( )	No ( )
Auto. Wash. Machine	Yes ( )	No ( )
Site Suitable	Yes (✓)	No ( )

Lot Area Ample

Character & Porosity of Soil


Percolation Rate

Topography

Depth to Water Table Repair.

Rock or other impervious formations

Basement with Plumbing Basement without Plumbing ✓ No Basement

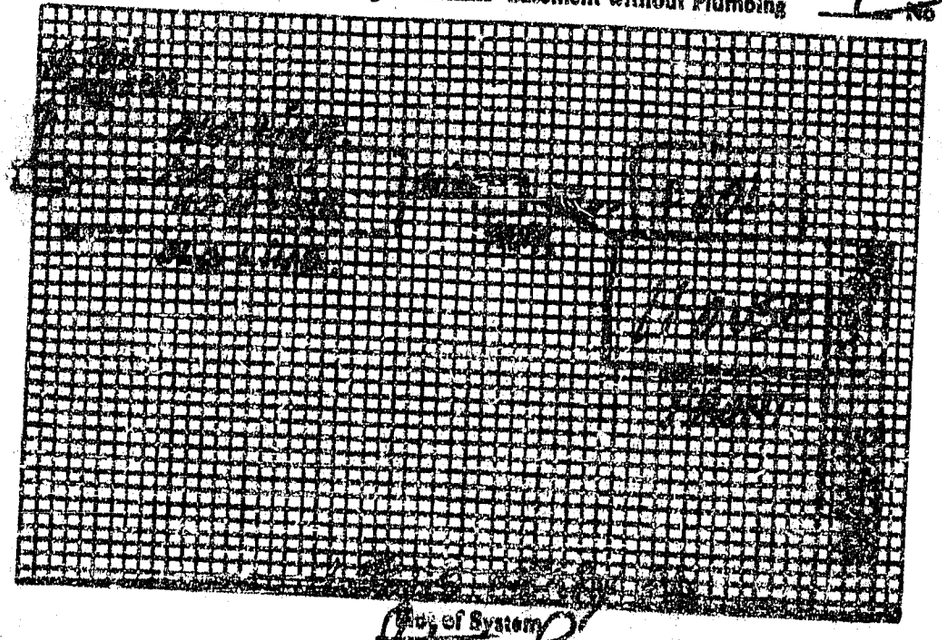

Size of Tank EXISTING Gals.

Nitrification Field:

No. of Lines 1

Sq. Ft. 200 Linear Ft. 100

Depth of Stone in Lines 12"

Water Supply: Individual (✓) Public

16 tank used & installed instead of new one

Installed by Donald Lackey

I understand and agree to install septic tank system as specified on this Improvements Permit.

Signed:

Plan of System

IMPROVEMENTS PERMIT BY Steve Brown

COMMENTS:

CERTIFICATE OF COMPLETION BY Steve Brown

EXISTING SYSTEM CHECKED BY: DATE 6-6-90

CONSTRUCTION MUST COMPLY WITH ALL OTHER APPLICABLE STATE AND LOCAL REGULATIONS. DATE

Permit is VOID if any unauthorized changes are made in installation of system and/or if any false information is supplied in making Improvements Permit.

Health Dept. Copy: White Inspection Dept. Copy: Yellow Sanitarian's Copy: Pink Owner's Copy: Gold