IREDELL COUNTY HEALTH DEPARTMENT - *ENVIRONMENTAL HEALTH* ☒ STATESVILLE OFFICE 704-878-5305 ☐ MOORESVILLE OFFICE 704-664-5281

IMPROVEMENT PERMIT / AUTHORIZATION TO CONSTRUCT / OPERATION PERMIT / EXISTING SYSTEM INSPECTION

PERMIT # Repair PIN # 4713-06-2242 DATE 4-3-12

OWNER Lyon McNeeley APPLICANT: PHONE: Home/Cell # 704 871 8859 Business #

SITE ADDRESS 198 E. Lewis Ferry Rd. OWNER / APPLICANT ADDRESS 198 Lewis Ferry Rd.

SITE DIRECTIONS Old Mtn Rd to E. Lewis Ferry Rd, 6th house on right

SUBDIVISION n/a BLOCK / SECTION n/a LOT # n/a LOT AREA 3.01 Ac. DESIGN FLOW 360 L.T.A.R. .3

Septic Tank 1000 Gallons: STB Date ☒ New System ☒ Repair ☐ Expansion System Type I II (III) IV V VI

Pump Tank Gallons: P T Date System Description:

Pump Make Model Serial # Repair System Description: 25% Reduction Gravity

No. Nitrification Fields: 1 No. Lines 3 Linear Feet ~~300~~ 270 Maintenance Agreement Required ☐ YES ☒ NO

Trench Width 36" Max. Trench Bottom Depth 36" Gravel Depth n/a ☒ GRAVITY ☐ PRESSURE


☒ Residence No. Bedrooms 3 ☐ Business No. Persons ☐ Other No. Employees ☐ Slab ☒ Crawl Space ☐ Basement w/plumbing ☐ Basement w/o plumbing

Water Supply: ☐ Private ☒ Public ☐ Community


Comments / Conditions

(4) ~~(3" x 15")~~

INITIAL SITE SKETCH

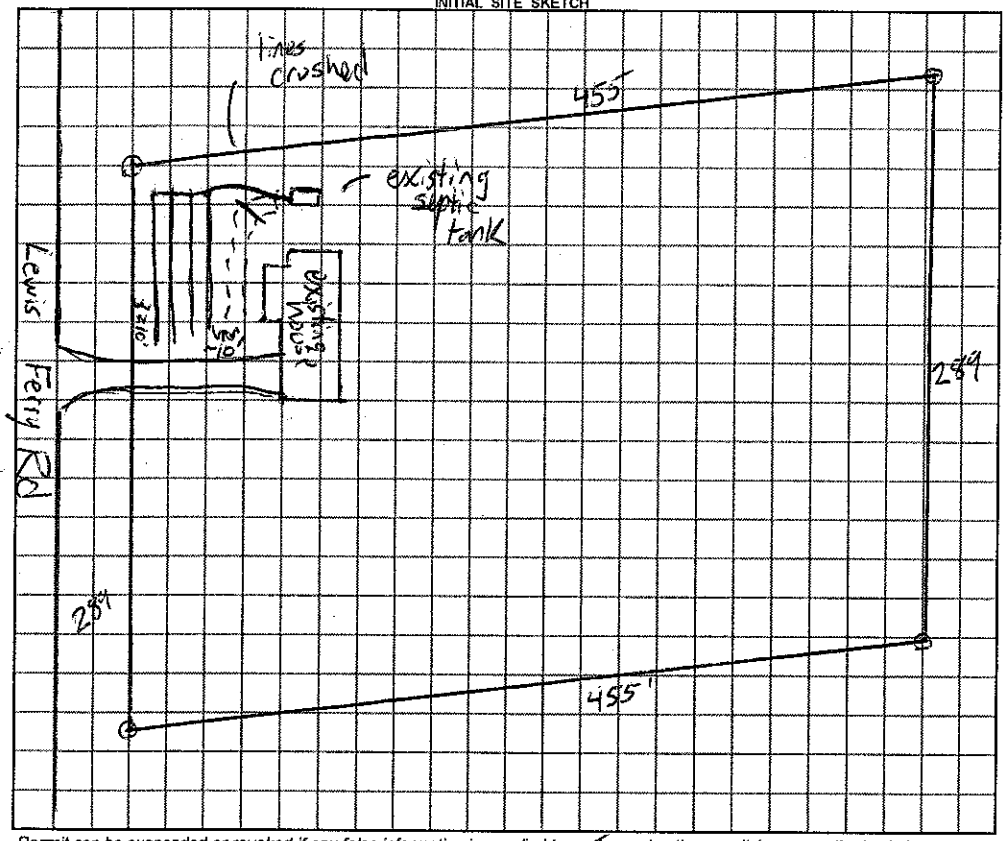

AS BUILT SKETCH

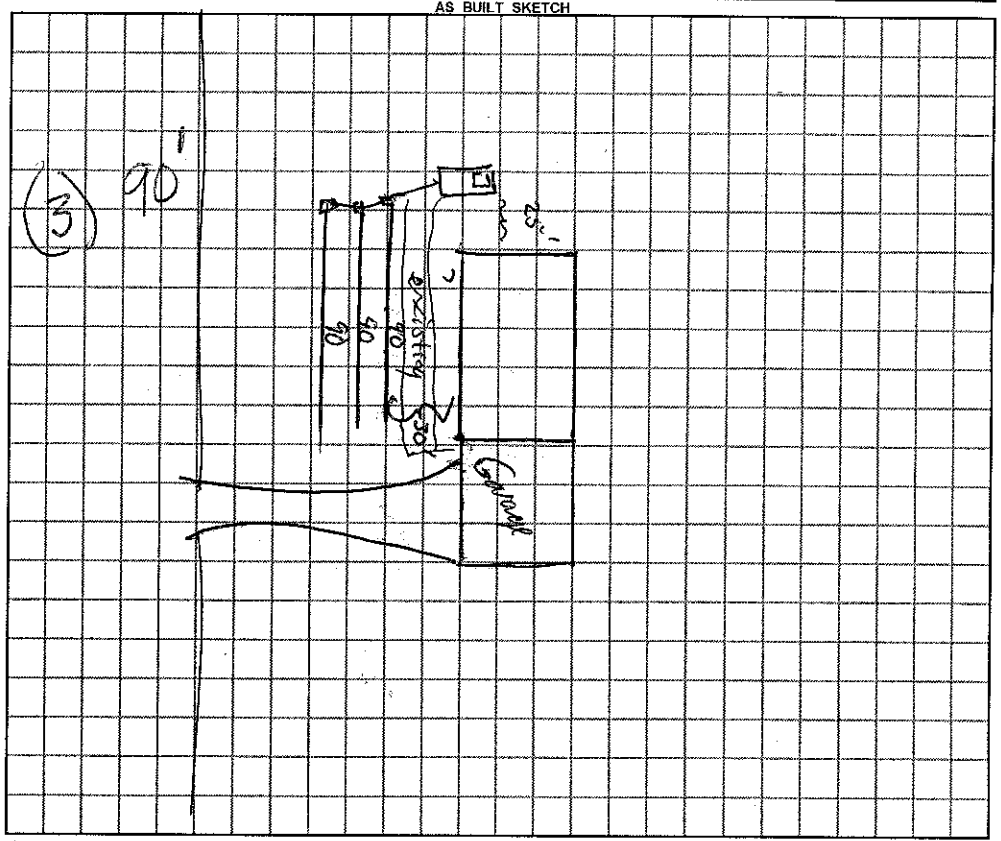

Permit can be suspended or revoked if any false information is supplied toward securing the permit / any unauthorized changes are made to the site / any unauthorized changes are made in the installation of the system.

☒ ***IMPROVEMENT PERMIT*** with plat valid without expiration. ☒ ***IMPROVEMENT PERMIT*** with plat valid without expiration. site plan valid 60 mo. ☒ ***AUTHORIZATION TO CONSTRUCT*** valid for period equal to IMPROVEMENT PERMIT--not to exceed 60 mo.

Owner / Applicant Signature: Lyon McNeely Date

IMPROVEMENT PERMIT by: REHS Date 4-3-12

AUTHORIZATION TO CONSTRUCT by: REHS Date 4-3-12

YOU SHOULD CONTACT A LOCATOR SERVICE PRIOR TO ANY EXCAVATION

Installed by: Tommy Ferguson

OPERATION PERMIT by: REHS Date 5-2-12

Existing System Inspected by: REHS Date

White Copy -- Environmental Health YELLOW COPY (Final) Owner / Applicant PINK COPY (Initial) Owner / Applicant