IREDELL COUNTY HEALTH DEPARTMENT

Statesville Phone TR 3-7271 Mooresville Phone NO 3-1271

PERMIT TO INSTALL SEPTIC TANK

Permit NO. Asa Hefner Elder. Permit Date May 2 - 1963

Owner _____ Address Cleste Henkle.

Installed By C Hoke Address R7 -


Location of Property left at white oak toward Cleste Henkle. School. R. on 1st pave 1 block on R.

Tank		Capacity		Length of Lines		Fixtures	
Block	( )	800	( )	150'	( )	No. of Baths	(2)
Precast	(✓)	900	( )	175'	( )	Dishwasher	( )
		1000	(✓)	200'	( )	Garbage Grdr.	( )
		1100	( )	225'	(✓)	Auto-Washer	(✓)
		1200	( )	250'	( )	Other	
		Other		Other			

NOTIFY HEALTH DEPARTMENT AT LEAST EIGHT HOURS BEFORE TANK IS TO BE INSPECTED.

Final Inspection 5-2 1963 Approved ( ) Disapproved ( )

Remarks Well 60' Ditch 5 wide end 0 wide 7½ ft. for 15'

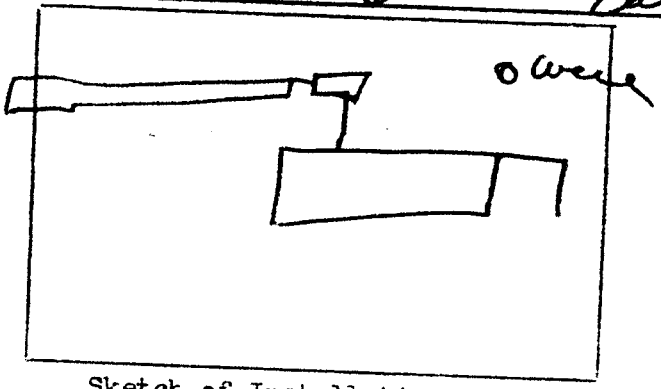

Sketch of Installation

Rut.

Sanitarian