CI

IREDELL COUNTY HEALTH DEPARTMENT

STATESVILLE 704-878-5305 MOORESVILLE 704-664-5281

IMPROVEMENT PERMIT / AUTHORIZATION TO CONSTRUCT / OPERATION PERMIT / EXISTING SYSTEM INSPECTION

PERMIT# 115353 PIN# 4713-07-3011 DATE 3-31-04

OWNER OR CONTRACTOR UNITED MODULAR HOMES BOB HADEN PHONE: Business 704-872-0227 Home 704-873-8179

ADDRESS P.O. BOX 1651 STATESVILLE, NC 28687

LOCATION 70 WEST (L) 6MR (R) LEWIS FERRY 0.3 mile on

SUBDIVISION W. NASH PROP BLOCK / SECTION LOT 3 LOT AREA 1.46 AC SITE CLASS PS DESIGN FLOW 360 L.T.A.R. .3

Septic Tank: 1000 Gallons; STB 794 Date 2-10-04
Pump Tank: Gallons; PT Date
Pump Make: Model Serial No.
Nitrification Field: No Fields 1 Square Feet 1200' Linear Feet 400'
No Lines 3X133' Trench Width 36" Max Trench Bottom Depth 36" Gravel Depth 12"

☒ New System ☐ Repair System Type: I, (II), III, IV, V, VI
System Description: CONV GRAV
Repair System Description: LP PANEL REPAIR
Maintenance Agreement Required: ☐ Yes ☒ No

☒ House/Mod. Home No. Bedrooms 3
☐ Mobile Home No. Bathrooms 2
☐ Business No. Employees
☐ Other


☐ Slab ☒ Crawl Space ☐ Basement w/plumbing ☐ Basement wo/plumbing

Water Supply: ☐ Individual ☒ Public ☐ Community


Comments:/Conditions: INSTALLED 5 LINES 30' LONG. 4 OF THE FIVE INTERSECTED THE OLD DRAIN LINES AS DRAWN. INSTALLER DID NOT STOP DIGGING. INSTALLER SAID LAST LINE DID NOT CUT INTO OLD DRAINFIELD. BRADY FREEMAN RS, LORNE LOOK RS &

Comments:/Conditions: WESLEY STARNES RS MET ON LOT & CONSULTED ON LOT. BEST OPTION IS TO FEED WHAT WAS INSTALLED. ADD 50' TO LINE #5 & ADD 2 NEW LINES BELOW IT INSTALLED ON CONTOUR AS DRAWN. TOTAL LENGTH OF LINE WILL BE 400'. IF DURING DIGGING OF NEW LINES ANY OLD DRAINFIELD IS ENCOUNTERED, STOP DIGGING IMMEDIATELY & CALL THE HEALTH DEPT. REPRESENTATIVES FROM THE HEALTH DEPT PROBED EXTENSIVELY IN THE NEW PROPOSED DRAINFIELD AREA & TO OUR BEST JUDGEMENT THE OLD DRAINFIELD IS NOT IN THE NEW DRAINFIELD AREA. UNITED MODULAR HOMES REP. BOB HADEN AUTHORIZED THE CHANGES VIA PHONE CALL 3-31-04.

INITIAL SITE SKETCH

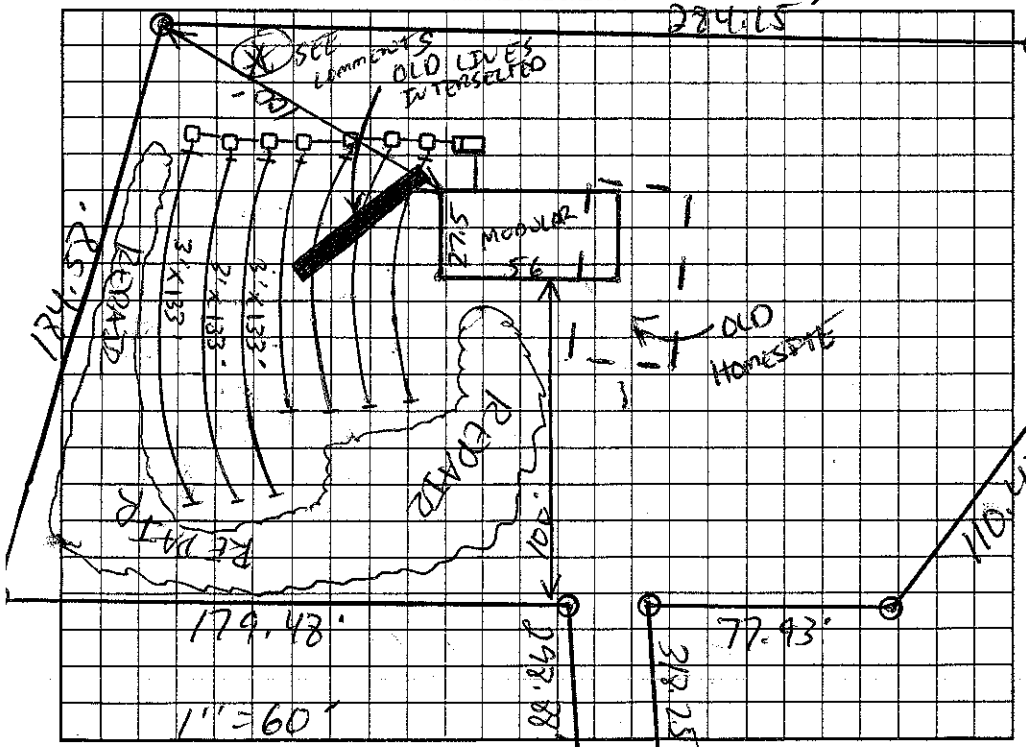

AS BUILT SKETCH

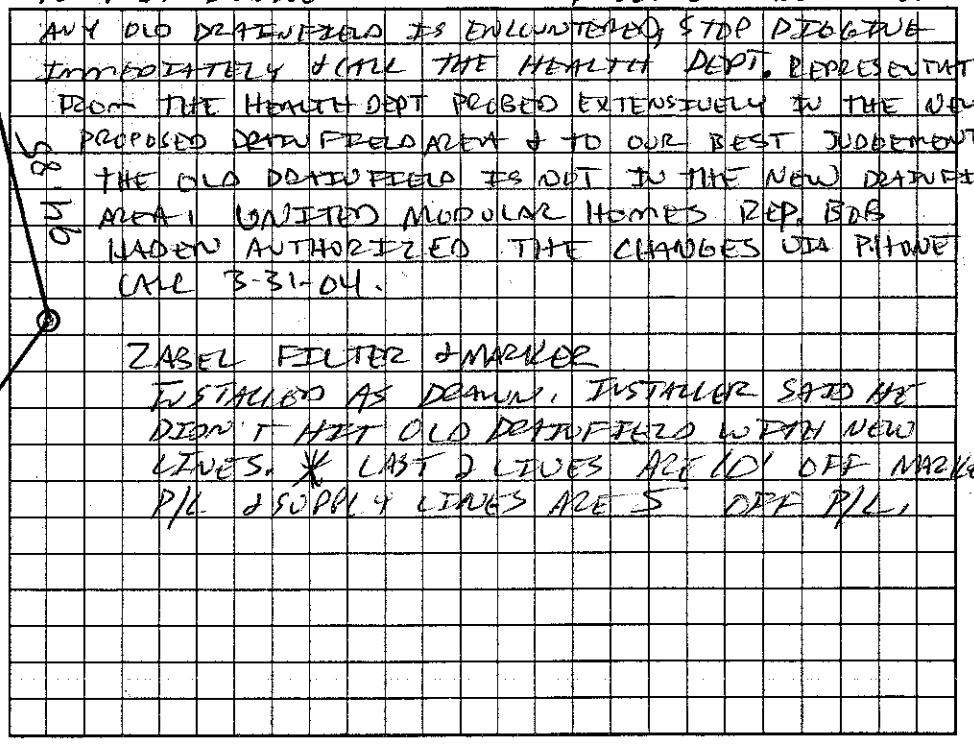

Permit can be suspended or revoked if any false information is supplied toward securing the permit/any unauthorized changes are made to the site/any unauthorized changes are made in the installation of the system. Improvement Permit with plat valid without expiration. Improvement Permit with site plan valid for sixty months. Authorization to Construct is valid for a period equal to that of Improvement Permit – not to exceed sixty months.

Signed: date

Improvement Permit by: date 3-31-04

Authorization to Construct by: date 3-31-04

Installed by: MARTY WALKER

Operation Permit by: date 4-8-04

Existing System Inspection by: date

HEALTH DEPT. COPY: WHITE OWNER COPY (FINAL): YELLOW OWNER COPY (INITIAL): PINK