Both!

IREDELL COUNTY HEALTH DEPARTMENT - *ENVIRONMENTAL HEALTH* ☐ STATESVILLE OFFICE 704-878-5305 ☐ MOORESVILLE OFFICE 704-664-5281

IMPROVEMENT PERMIT / AUTHORIZATION TO CONSTRUCT / OPERATION PERMIT / EXISTING SYSTEM INSPECTION

PERMIT # 168909 - 168910 PIN # 4713-08-6692 DATE 25 October 2011

OWNER Jenny Price APPLICANT: PHONE: Home/Cell # Business # 704-878-0330

SITE ADDRESS 1731 Old Mtn. Rd. Statesville OWNER / APPLICANT ADDRESS

SITE DIRECTIONS Hwy 40 W TL Old Mtn Rd. on Rt. before NC 70

SUBDIVISION Jenny Price Apartments BLOCK / SECTION LOT # LOT AREA 0.7 ac. DESIGN FLOW 720 gpd total L.T.A.R. 0.3 gpd/ft²

Septic Tank 2X1000g Gallons: STB ①1012 ②1012 Date ①9-27-11 ②9-29-11 ☑ New System ☐ Repair ☐ Expansion System Type I II (III) IV V VI

Pump Tank Gallons: P T Date System Description: 25% Reduction

Pump Make Model Serial # Repair System Description: LPP PPBPS

No. Nitrification Fields: 2 No. Lines 8 Linear Feet 600 Maintenance Agreement Required ☐ YES ☑ NO


Trench Width 36" Max. Trench Bottom Depth 36" Gravel Depth N/A ☑ GRAVITY ☐ PRESSURE

☑ Residence No. Bedrooms 6 total ☐ Business No. Persons ☑ Other Duplex No. Employees ☑ Slab ☐ Crawl Space ☐ Basement w/plumbing ☐ Basement w/o plumbing


Water Supply: ☐ Private ☑ Public ☐ Community

Comments / Conditions Permit for 2 Three bedroom apartments.
Maintain 20' separation between systems.

INITIAL SITE SKETCH

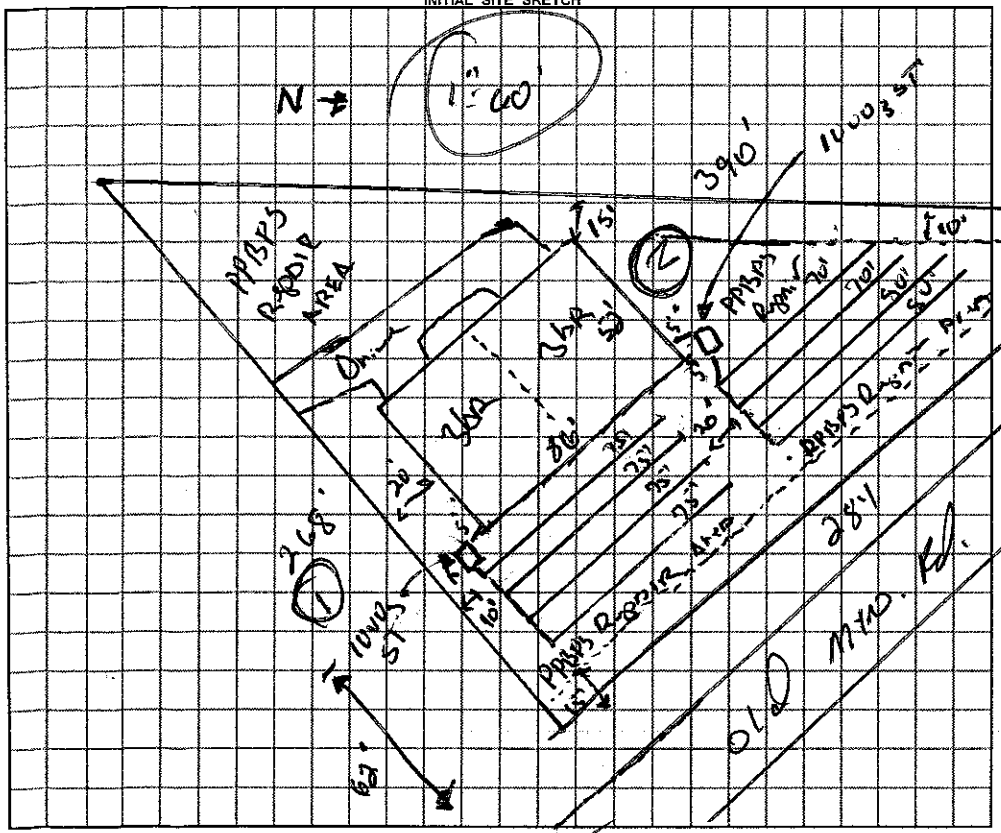

AS BUILT SKETCH

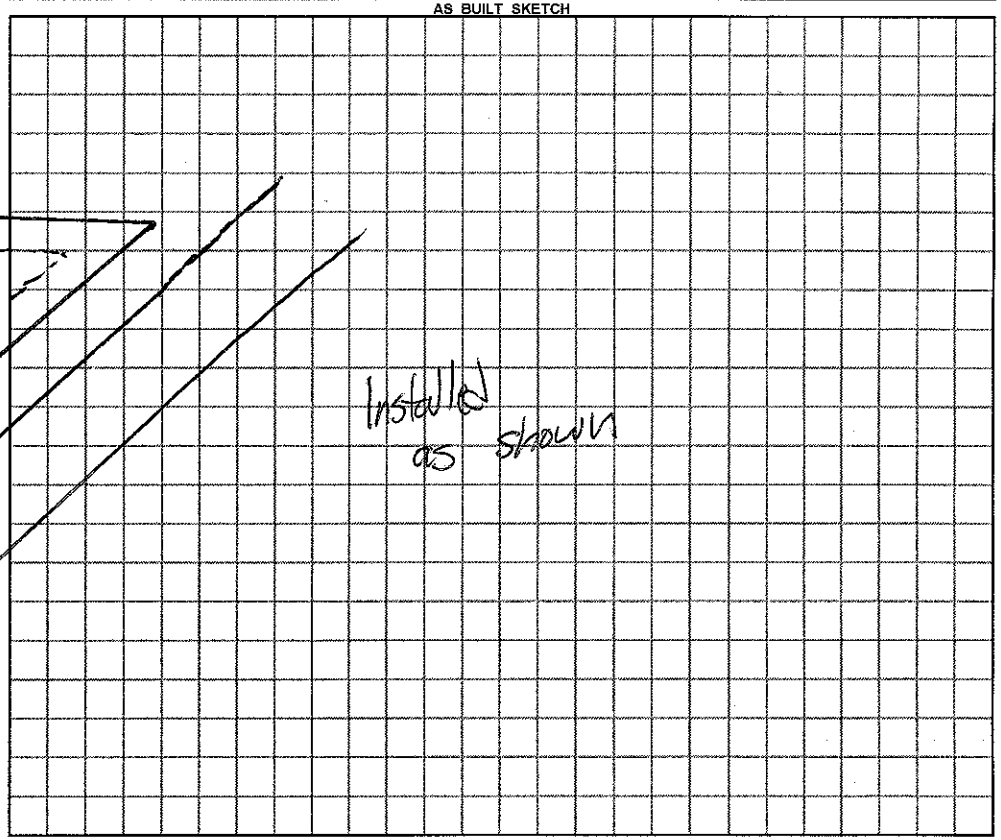

Permit can be suspended or revoked if any false information is supplied toward securing the permit / any unauthorized changes are made to the site / any unauthorized changes are made in the installation of the system.

☐ ***IMPROVEMENT PERMIT*** *with plat valid without expiration.* ☑ ***IMPROVEMENT PERMIT*** *with plot valid without expiration. site plan valid 60 mo.* ☑ ***AUTHORIZATION TO CONSTRUCT*** valid for period equal to IMPROVEMENT PERMIT--not to exceed 60 mo.

Owner / Applicant Signature: Date 10-26-11 Installed by: Gunter Gradison

IMPROVEMENT PERMIT by: REHS Date 25 Oct. 11 OPERATION PERMIT by: REHS Date 2-22-12

AUTHORIZATION TO CONSTRUCT by: REHS Date 25 Oct. 11 Existing System Inspected by: REHS Date

YOU SHOULD CONTACT A LOCATOR SERVICE PRIOR TO ANY EXCAVATION

White Copy -- Environmental Health YELLOW COPY (Final) Owner / Applicant PINK COPY (Initial) Owner / Applicant