IREDELL COUNTY HEALTH DEPARTMENT

STATESVILLE 704-878-5305 CI MOORESVILLE 704-664-5281

IMPROVEMENT PERMIT / AUTHORIZATION TO CONSTRUCT / OPERATION PERMIT / EXISTING SYSTEM INSPECTION

PERMIT # 154042 PIN # 4713087263 DATE 12/19/08

OWNER or APPLICANT Jerry Price PHONE: Business 704-902-4355 Home: 704-878-0330

OWNER or APPLICANT ADDRESS 239 LEWIS Ferry Rd Statesville NC 28677

LOCATION / DIRECTIONS 70 WEST ON RT JOST PAST OLD MTN RD

SUBDIVISION N/A BLOCK / SECTION N/A LOT # N/A LOT AREA .845 DESIGN FLOW 480 L.T.A.R. .25

Septic Tank 2/1000 Gallons: STB/1012/1012 Date 11/17/08 11/17/08

Pump Tank ____ Gallons: P T ____ Date ____

Pump Make ____ Model ____ Serial # ____

Nitrification Field No Fields ____ No Lines 8 Linear Feet 480'

Trench Width 36" Max. Trench Bottom Depth 36" Gravel Depth N/A

☒ New System ☐ Repair ☐ Expansion System Type I II (III) IV V VI

System Description: GRAVITY 25% REDUCTION

Repair System Description: LOW PRESSURE 50% REDUCTION

Maintenance Agreement Required ☐ YES ☒ NO

☐ GRAVITY ☐ PRESSURE

☐ Residence No. Bedrooms 4

☐ Business No. Persons ____

☒ Other No. Employees ____

☒ Slab ☐ Crawl Space

☐ Basement w/plumbing ☐ Basement w/o plumbing

Water Supply: ☐ Private ☒ Public ☐ Community

Comments / Conditions (1) Builder is AWARE OF The limited Space this system has and system is flagged out completely (2) IF ENOUGH ROOM CAN BE ACHIEVED USE FLOW DIVIDER TEE IN EQUIT SPLIT

INITIAL SITE SKETCH

SEE ATTACHED SYSTEM DESIGN BY LORNE COOK, R.S.

Comments / Conditions System for better distribution. CALL BEFORE INSTALLATION TO DISCUSS. (3) NO CUTTING OR GRADING CAN BE DONE IN System & Repair Area. (4) Read Comments on Permit Drawing (5) MAINTAIN SETBACKS.

AS BUILT SKETCH

(6) This is 1 Unit on 2 systems. IT still is considered 1 system & 1 unit SO 20' seperation is not required.


1ST TANK IS 11' OFF D/L MARKED

- ALL Septic Lines & Tanks ARE 10' OFF MARKED D/L
- 15' OFF ENSEMENT CUT

House shrunk in size Length

USED END CAP BEST WITH 2 FLOW DIVIDING TEE'S - 1 in each System

1/8" FALL PER FOOT ON supply lines

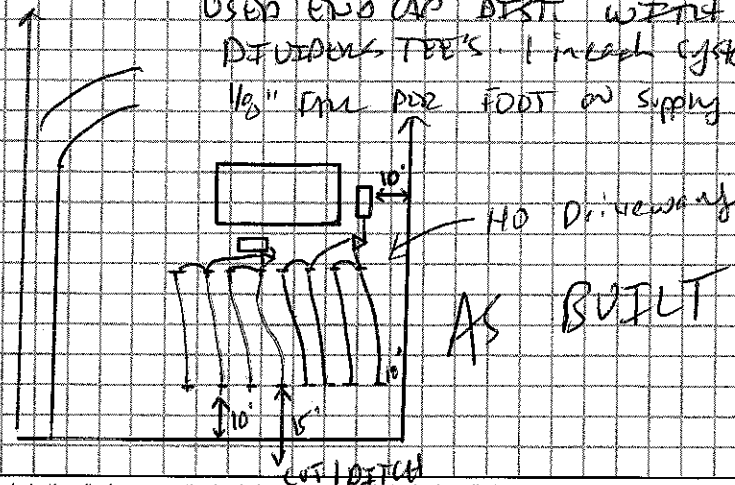

AS BUILT

Permit can be suspended or revoked if any false information is supplied toward securing the permit / any unauthorized changes are made to the site / any unauthorized changes are made in the installation of the system.

☐ *IMPROVEMENT PERMIT w/ plat valid without expiration.* ☒ *IMPROVEMENT PERMIT w / site plan valid for 60 mos.* ☐ *AUTHORIZATION TO CONSTRUCT valid for period equal to IMPROVEMENT PERMIT-not to exceed 60 mo.*

Owner / Applicant Signature: Jerry Price Date 12-19-08

Improvement Permit by: L. Cook RS Date 12-19-08

Authorization to Construct by: L. Cook RS Date 12-19-08

YOU SHOULD CONTACT A LOCATOR SERVICE PRIOR TO ANY EXCAVATION.

Installed by: GUNTHER GRADING

Operation Permit by: L. Cook RS Date: 6-4-09

Existing System Inspected by: ____ Date: ____

WHITE COPY Environmental Health YELLOW COPY (Final) Owner / Applicant PINK COPY (Initial) Owner / Applicant