IREDELL COUNTY HEALTH DEPARTMENT

STATESVILLE 704-878-5305 MOORESVILLE 704-664-5281

IMPROVEMENT PERMIT / AUTHORIZATION TO CONSTRUCT / OPERATION PERMIT / EXISTING SYSTEM INSPECTION

PERMIT# REPAIR PIN#

OWNER OR CONTRACTOR MIKE ESTES DATE

ADDRESS 1759 OLD MOUNTAIN ROAD PHONE: Business Home 873-0739

LOCATION I-40 WEST, TL OLD MOUNTAIN ROAD, ON RIGHT AT STATESVILLE, NC 28677 BOX # 1759

SUBDIVISION BLOCK / SECTION LOT LOT AREA SITE CLASS: PS DESIGN FLOW 360 L.T.A.R. EXISTING

Septic Tank: 1000 Gallons; STB 1012 Date 8-21-98

Pump Tank: Gallons; PT Date

Pump Make: Model Serial No.

Nitrification Field: No Fields 1 Square Feet 180 Linear Feet 60

No Lines TWO Trench Width 36" Max Trench Bottom Depth 36" Gravel Depth (24")

☐ New System ☑ Repair System Type: I, II, III, IV, V, VI

System Description: CONVENTIONAL GRAVITY

Repair System Description: CONV. GRAVITY

Maintenance Agreement Required: ☐ Yes ☑ No

☑ House/Mod. Home ☐ Mobile Home ☐ Business ☐ Other

No. Bedrooms 3 No. Bathrooms 2 No. Employees


☐ Slab ☑ Crawl Space ☐ Basement w/plumbing ☐ Basement wo/plumbing

Water Supply: ☐ Individual ☑ Public ☐ Community


Comments:/Conditions: ① ABANDON EXISTING SEPTIC TANK BY CRUSHING & FILLING WITH SOIL FROM NEW TANK HOLE ② USE 24" STONE DEPTH.

Comments:/Conditions: EXISTING LINES WORKING O.K. NO NEW LINES INSTALLED PER HOMEOWNER

INITIAL SITE SKETCH

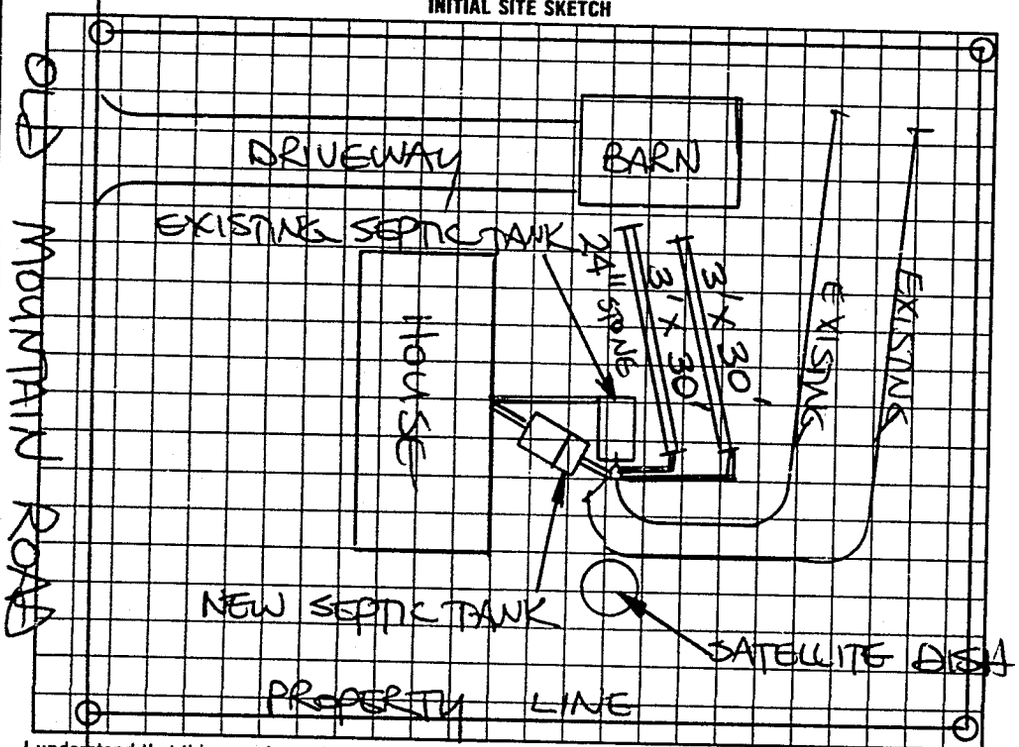

AS BUILT SKETCH

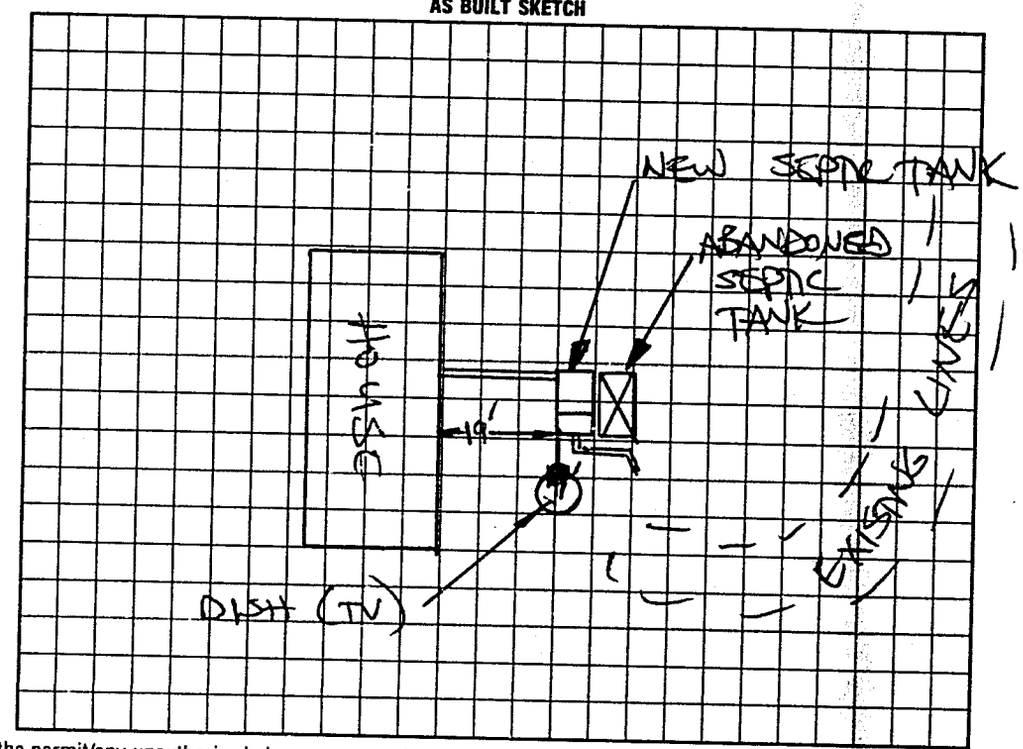

I understand that this permit can be suspended or revoked if any false information is supplied toward securing the permit/any unauthorized changes are made to the site/any unauthorized changes are made in the installation of the system. Improvement Permit with plat valid without expiration. Improvement Permit with site plan valid for sixty months. Authorization to Construct is valid for a period equal to that of Improvement Permit – not to exceed sixty months.

Signed: [signature] date 10-19-98 Installed by: J. C. FORSYTH

Improvement Permit by: STEVE HEDRICK date 10-19-98 Operation Permit by: STEVE HEDRICK date 10-26-98

Authorization to Construct by: STEVE HEDRICK date 10-19-98 Existing System Inspection by: date

HEALTH DEPT. COPY: WHITE INSPECTION COPY (FINAL): GREEN OWNER COPY (FINAL): YELLOW INSPECTION COPY (INITIAL): PINK OWNER COPY (INITIAL): GOLD