IREDELL COUNTY HEALTH DEPARTMENT

Statesville Office (704) 878-5305 Mooresville Office (704) 660-3625 PERMIT # 202274

IMPROVEMENT PERMIT / AUTHORIZATION TO CONSTRUCT / OPERATION PERMIT / EXISTING SYSTEM

PIN # 4713149886

APPLICANT: Jerry Price APPLICANT ADDRESS: 239 Lewis Ferry Statesville NC

SITE ADDRESS: 137 Jack Terrace Ln Statesville NC PHONE: 704-878-0330 ALT. PHONE: N/A

SITE DIRECTIONS: Lewis Ferry Rd (L) Jack Terrace Ln, Stay Strait onto gravel drive.

SUBDIVISION: N/A SECTION: N/A LOT # N/A LOT AREA: 6.872 ac DESIGN FLOW: 360 L.T.A.R.: EX

Septic Tank	EX	(gal)	STB	EX	Date	EX			
Pump Tank	N/A	(gal)	PT	N/A	Date	N/A			
Pump Make	N/A	Model	N/A		Serial #	N/A			
# Nitrification Fields	1	# Lines	3		Linear Ft:	EX			
Trench Width	EX	Max. Trench Bottom Depth	EX		Gravel Depth	EX			

☐ New System ☐ Repair ☐ Expansion System Type: I (II) III IV V VI

System Description: Existing

Repair System Description:

Maintenance Agreement Required: ☐ YES ☒ NO

☒ GRAVITY ☐ PRESSURE


☒ Residence No. Bedrooms 3
☐ Business No. Persons 6
☐ Other No. Employees
☐ Slab ☐ Crawl Space
☒ Basement w/plumbing ☐ Basement w/o plumbing

Water Supply: ☐ Private ☒ Public ☐ Community

Comments / Conditions: All building foundations must be 35' from any part of STS. Mobile Home must be moved before CO is granted.

INITIAL SITE SKETCH

AS BUILT SKETCH

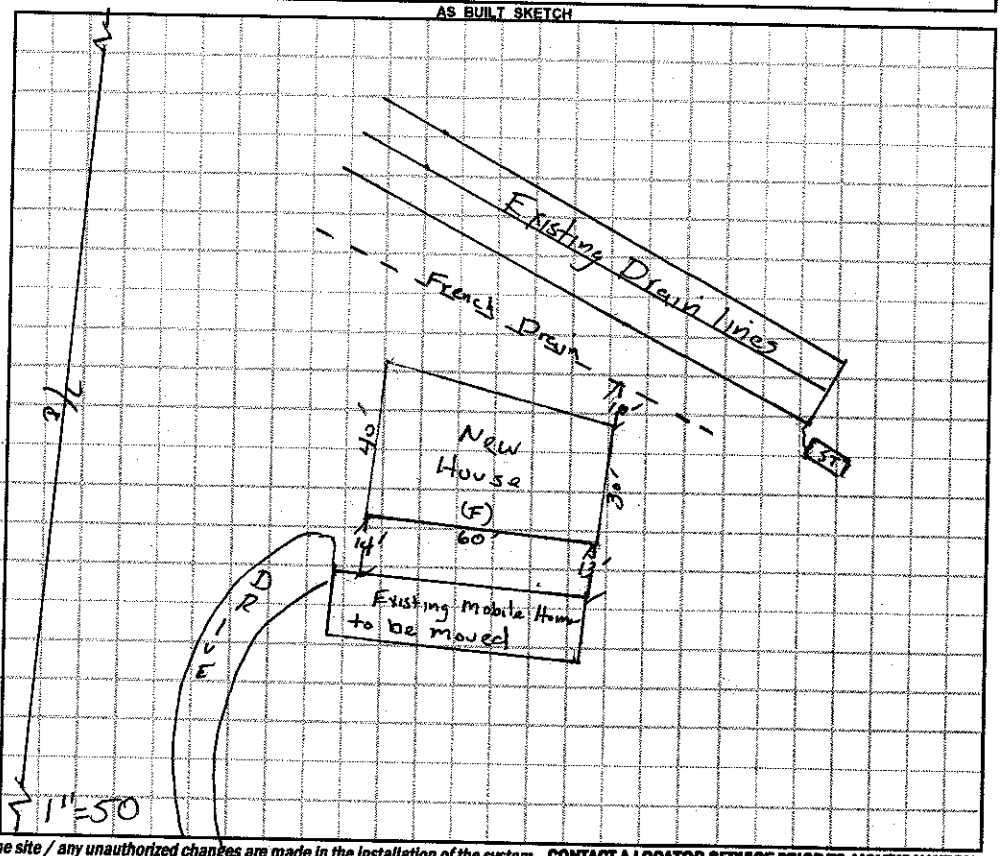

Permit can be suspended or revoked if any false information is supplied toward securing the permit / any unauthorized changes are made to the site / any unauthorized changes are made in the installation of the system. **CONTACT A LOCATOR SERVICE PRIOR TO ANY EXCAVATION**

☐ **IMPROVEMENT PERMIT** *with plat valid without expiration.* ☐ **IMPROVEMENT PERMIT** *with site plan valid for 60 mos.* ☐ **AUTHORIZATION TO CONSTRUCT** *valid for period equal to IMPROVEMENT PERMIT--not to exceed 60 mo.*

Owner / Applicant Signature: [signature] Date: Installed by:

IMPROVEMENT PERMIT by: Date: OPERATION PERMIT by: Date:

AUTHORIZATION TO CONSTRUCT by: Date: Existing System Inspected by: [signature] Date: 04/02/14

Health Dept. Copy - WHITE Applicant (Final Approval) - YELLOW Applicant (Conditional Approval) - PINK