IREDELL COUNTY HEALTH DEPARTMENT

Statesville Phone TR 3-7271 Mooresville Phone No. 664-5281

PERMIT TO INSTALL SEPTIC TANK

Permit No. [illegible] Permit Date 10-30 1973

Owner Bunny Babbs Address Statesville N.C.

Installed By Henry Sigmon Address Statesville N.C.


Location of Property Lewis Ferry Road #1369
1st Brick House on L

Tank		Capacity		Length of Lines		Fixtures	
Block	( )	1000	( )	225'	( )	No. of Baths	( )
Precast	( )	1250	( )	250'	( )	Dishwasher	( )
		1500	( )	Other 200'		Garbage Grdr.	( )
		Other				Other	

NOTIFY HEALTH DEPARTMENT AT LEAST EIGHT HOURS BEFORE TANK IS TO BE INSPECTED.

Final Inspection 10-30 1973 Approved (✓) Disapproved ( )

Remarks

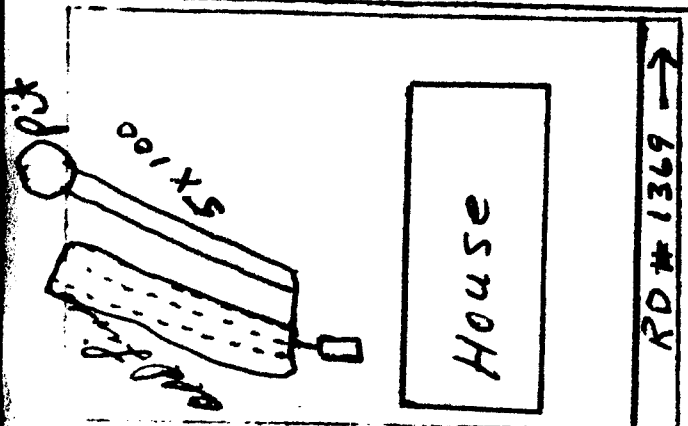

Sketch of Installation

Repair -
40 Ton Stone
used

E. G. Stevenson
Sanitarian