IREDELL COUNTY HEALTH DEPARTMENT

STATESVILLE 704-878-5305 MOORESVILLE 704-664-5281

IMPROVEMENT PERMIT / CERTIFICATE OF COMPLETION / OPERATION PERMIT / EXISTING SYSTEM INSPECTION

PROPERTY DESCRIPTION NO. 23255 DATE 3-7-96 TAX MAP NO 87-B-150 Watershed: Yes ~~No~~

OWNER OR CONTRACTOR Bennie Babb III PHONE Business Home 872-4354

ADDRESS 113 Lewis Ferry Rd Statesville

LOCATION I-40 W TL Old Mth Rd Past Whiteoak TR Lewis Ferry Rd 1/8 mi TL Private Rd

SUBDIVISION BLOCK / SECTION LOT LOT AREA SITE CLASS DESIGN FLOW L T A R

Septic Tank: 1000 Gallons; STB Date

Pump Tank: Gallons; PT Date

Pump Make: Model Serial No

Nitrification Field: No Fields 1 Square Feet 600 Linear Feet 200

No Lines 2 Trench Width 36 Max Trench Bottom Depth 36 Gravel Depth 12

New System Repair System Type C O N V E N T I O N A L

System Description

Repair System Description

Maintenance Agreement Required Yes No

✓ Slab Crawl Space Basement w/plumbing Basement w/o plumbing

House/Mod Home No Bedrooms 1

Mobile Home No Bathrooms 2

Business No Employees

Other

Water Supply: Individual, Community, ~~Public~~


Comments:

Comments

3'x100' 3'x100'

INITIAL SITE SKETCH

AS BUILT SKETCH

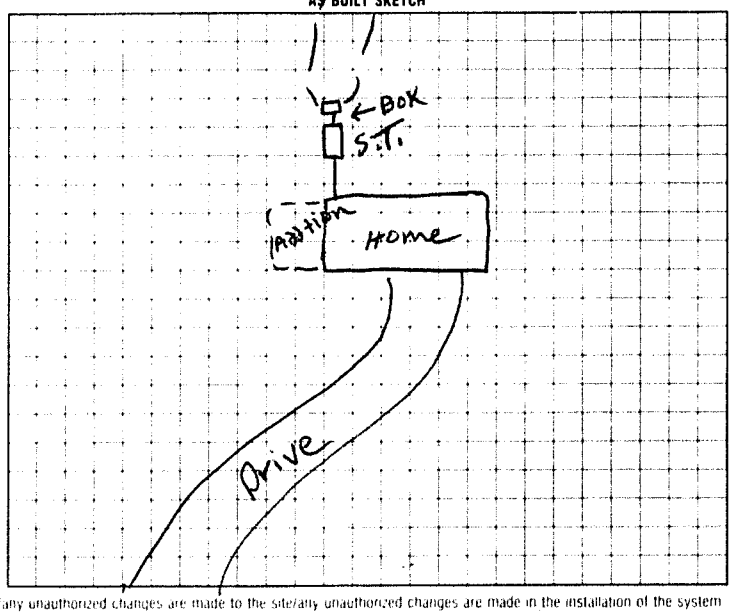

I understand that this permit can be suspended or revoked if any false information is supplied toward securing the permit; any unauthorized changes are made to the site; any unauthorized changes are made in the installation of the system

Signed

Installed by Donald Lackey / Bennie Babb III

Improvement Permit by date

Certificate of Completion by date 4-28-89

Existing System Inspection by R. C. Moore date 3-7-96

Operation Permit by date

HEALTH DEPT COPY WHITE INSPECTION COPY (FINAL) GREEN OWNER COPY (FINAL) YELLOW INSPECTION COPY (INITIAL) PINK OWNER COPY (INITIAL) GOLD