IREDELL COUNTY HEALTH DEPARTMENT

STATESVILLE 704-878-5305 MOORESVILLE 704-664-5281

IMPROVEMENT PERMIT / AUTHORIZATION TO CONSTRUCT / OPERATION PERMIT / EXISTING SYSTEM INSPECTION

PERMIT# REPAIR PIN# 4713 17 9202 DATE 2-12-01

OWNER OR CONTRACTOR RONALD S. HOLLIFIELD PHONE: Business Home (704) 871-1175

ADDRESS P.O. BOX 1036, TROUTMAN NC 28166

LOCATION I-40 W, TL OLD MOUNTAIN RD, TR LEWIS FERRY ROAD, 1ST HOUSE ON LEFT

SUBDIVISION BLOCK / SECTION LOT LOT AREA AMPLE SITE CLASS PS DESIGN FLOW 480 L.T.A.R. EXISTING 0.40gpd/ft

Septic Tank: 1000 Gallons: STB 794 Date 11-11-01

Pump Tank: Gallons: PT Date

Pump Make: Model Serial No.

Nitrification Field: No Fields 1 Square Feet 1200 Linear Feet 400

No Lines FIVE Trench Width 36" Max Trench Bottom Depth 36" Gravel Depth 12"

☑ New System ☑ Repair System Type: I II III IV V VI

System Description: CONVENTIONAL GRAVITY

Repair System Description: CONVENTIONAL GRAVITY

Maintenance Agreement Required: ☐ Yes ☑ No

☑ House/Mod. Home No. Bedrooms 4

☐ Mobile Home No. Bathrooms 2 1/2

☐ Business No. Employees

☐ Other


☐ Slab ☑ Crawl Space ☐ Basement w/plumbing ☑ Basement wo/plumbing

Water Supply: ☐ Individual ☑ Public ☐ Community

Comments/Conditions: ① ABANDON EXISTING SEPTIC TANK BY PUMPING & FILLING WITH DIRT EXCAVATED FROM NEW TANK HOLE. ② TIE WASHER DRAIN INTO NEW SEPTIC TANK

Comments/Conditions: - 2ASEL Filter Installed
Septic Tank Riser(2) Installed
(Old Tank Pumped & Crushed)

INITIAL SITE SKETCH

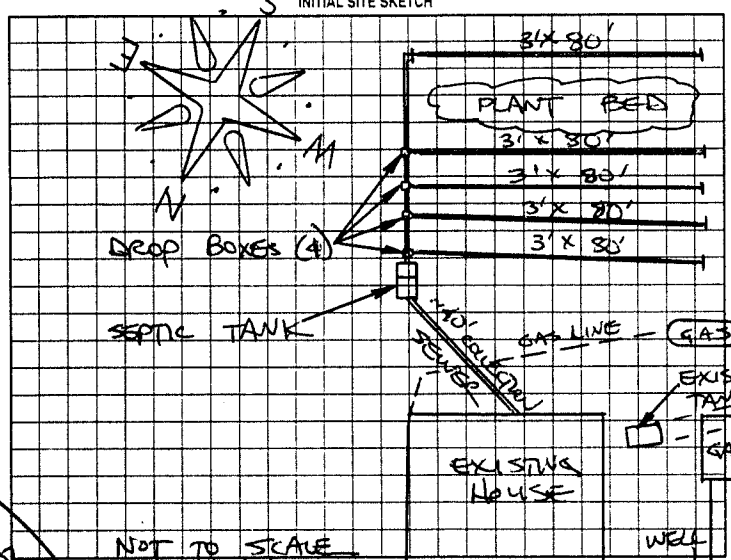

AS BUILT SKETCH

Installed as Shown

Permit can be suspended or revoked if any false information is supplied toward securing the permit/any unauthorized changes are made to the site/any unauthorized changes are made in the installation of the system. Improvement Permit with plat valid without expiration. Improvement Permit with site plan valid for sixty months. Authorization to Construct is valid for a period equal to that of Improvement Permit - not to exceed sixty months.

Signed: date 2-12-01 Installed by: F. J. Ervin

Improvement Permit by: STEVE HEDRICK date 2-12-01 Operation Permit by: William O. Johnson date 6/26/01

Authorization to Construct by: STEVE HEDRICK date 2-12-01 Existing System Inspection by: date

WHITE COPY - OFFICE COPY (FINAL) YELLOW COPY - OWNER COPY (INITIAL) PINK