IREDELL COUNTY HEALTH DEPARTMENT - *ENVIRONMENTAL HEALTH* ☐ STATESVILLE OFFICE 704-878-5305 ☐ MOORESVILLE OFFICE 704-664-5281

IMPROVEMENT PERMIT / AUTHORIZATION TO CONSTRUCT / OPERATION PERMIT / EXISTING SYSTEM INSPECTION @

PERMIT # 164848 PIN # 4713182737 DATE 2-1-11

OWNER Glenda Beam APPLICANT: PHONE: Home/Cell # 704 500 7845 Business #

SITE ADDRESS 1710 Old Mtn Rd. OWNER / APPLICANT ADDRESS

SITE DIRECTIONS I-40W, (L) on Old Mtn. Rd. @ 1710 Old Mtn. Rd.

SUBDIVISION Spring Valley BLOCK / SECTION LOT # 20 LOT AREA .408 DESIGN FLOW 360 L.T.A.R. ex

Septic Tank ex Gallons: STB Date

Pump Tank Gallons: P T Date

Pump Make Model Serial #

No. Nitrification Fields: 1 No. Lines ex Linear Feet ex

Trench Width ex Max. Trench Bottom Depth ex Gravel Depth ex

☐ New System ☐ Repair ☐ Expansion System Type I II III IV V VI

System Description: existing

Repair System Description:

Maintenance Agreement Required ☐ YES ☒ NO

☒ GRAVITY ☐ PRESSURE

☒ Residence No. Bedrooms 3

☐ Business No. Persons

☐ Other No. Employees

☐ Slab ☒ Crawl Space


☐ Basement w/plumbing ☐ Basement w/o plumbing

Water Supply
☐ Private
☐ Public
☐ Community

Comments / Conditions

INITIAL SITE SKETCH

AS BUILT SKETCH

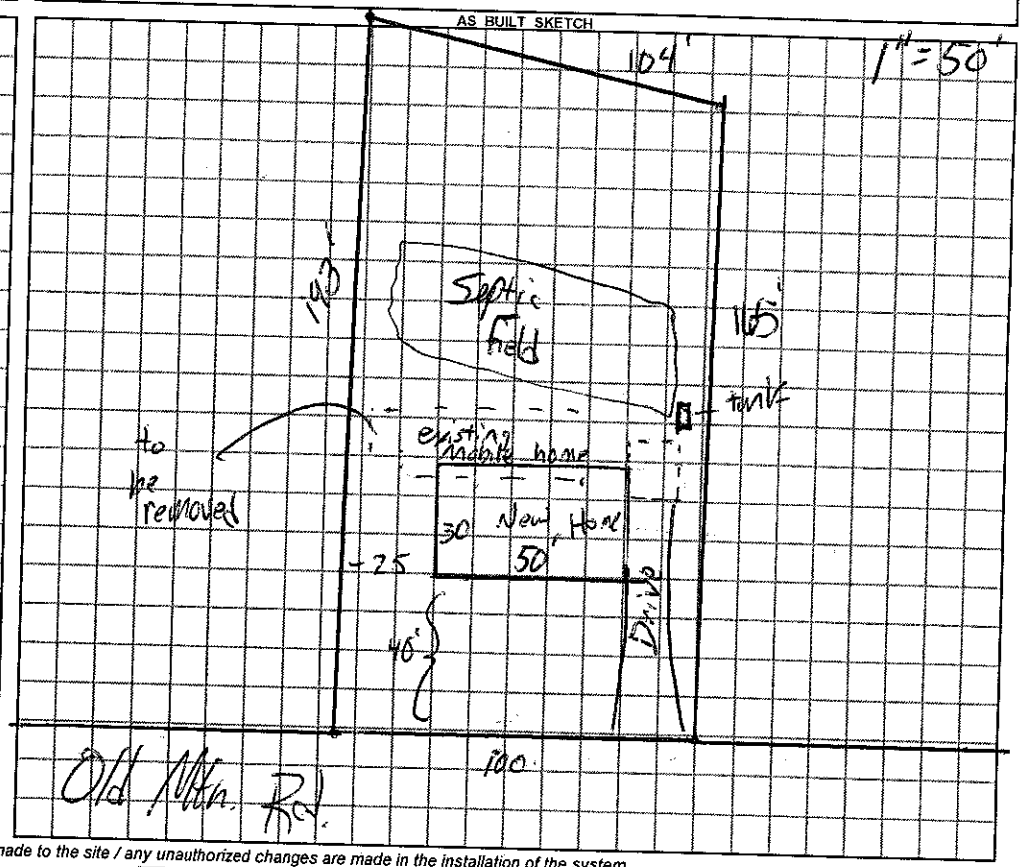

Permit can be suspended or revoked if any false information is supplied toward securing the permit / any unauthorized changes are made to the site / any unauthorized changes are made in the installation of the system.

☐ ***IMPROVEMENT PERMIT*** *with plat valid without expiration.* ☐ ***IMPROVEMENT PERMIT*** *with plat valid without expiration.* ☐ ***AUTHORIZATION TO CONSTRUCT*** valid for period equal to IMPROVEMENT PERMIT--not to exceed 60 mo.

Owner / Applicant Signature: Glenda Beam Date 2-1-11 Installed by:

IMPROVEMENT PERMIT by: REHS Date

AUTHORIZATION TO CONSTRUCT by: REHS Date

YOU SHOULD CONTACT A LOCATOR SERVICE PRIOR TO ANY EXCAVATION

OPERATION PERMIT by: REHS Date

Existing System Inspected by: REHS Date 2-1-11

White Copy – Environmental Health YELLOW COPY (Final) Owner / Applicant PINK COPY (Initial) Owner / Applicant