IREDELL COUNTY HEALTH DEPARTMENT

Statesville Office (704) 878-5305 Mooresville Office (704) 660-3625

PERMIT # 21391 4

IMPROVEMENT PERMIT / AUTHORIZATION TO CONSTRUCT / OPERATION PERMIT / EXISTING SYSTEM

PIN # 4713257986

APPLICANT: Tommy Wingler APPLICANT ADDRESS: 1324 old Mountain Rd Statesville NC 28677

SITE ADDRESS: 1551 old Mountain Rd Statesville NC 28677 PHONE: 704-902-4677 ALT. PHONE: 704-902-4678

SITE DIRECTIONS: Tow T/L old mtn Rd Property on right before School.

SUBDIVISION: N/A SECTION: N/A LOT # N/A LOT AREA: 38.159ac DESIGN FLOW: 360 L.T.A.R.: .825

Septic Tank 1000 (gal) STB 1012 Date 9/9/15

Pump Tank (gal) PT Date

Pump Make Model Serial #

Nitrification Fields 1 # Lines 3 Linear Ft: 360

Trench Width 36" Max. Trench Bottom Depth 24" Gravel Depth N/A

[X] New System [ ] Repair [ ] Expansion System Type: I II [III] IV V VI

System Description: 25% Reduction

Repair System Description: 25% Reduction

Maintenance Agreement Required: [ ] YES [X] NO

[X] GRAVITY [ ] PRESSURE

[X] Residence No. Bedrooms 3

[ ] Business No. Persons 6

[ ] Other No. Employees


[ ] Slab [Y] Crawl Space

[ ] Basement w/plumbing [ ] Basement w/o plumbing


Water Supply: [X] Private [ ] Public [ ] Community

Comments / Conditions: Install 25% reduction on contour with serial distribution.

INITIAL SITE SKETCH

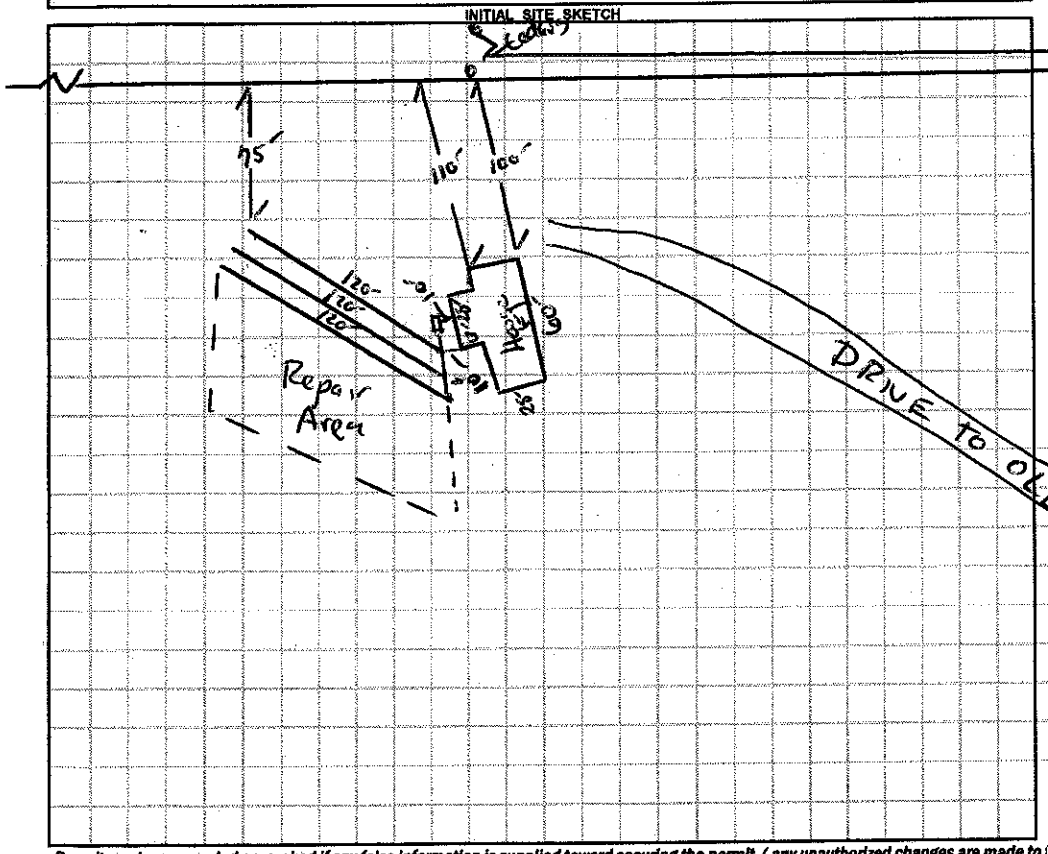

AS BUILT SKETCH

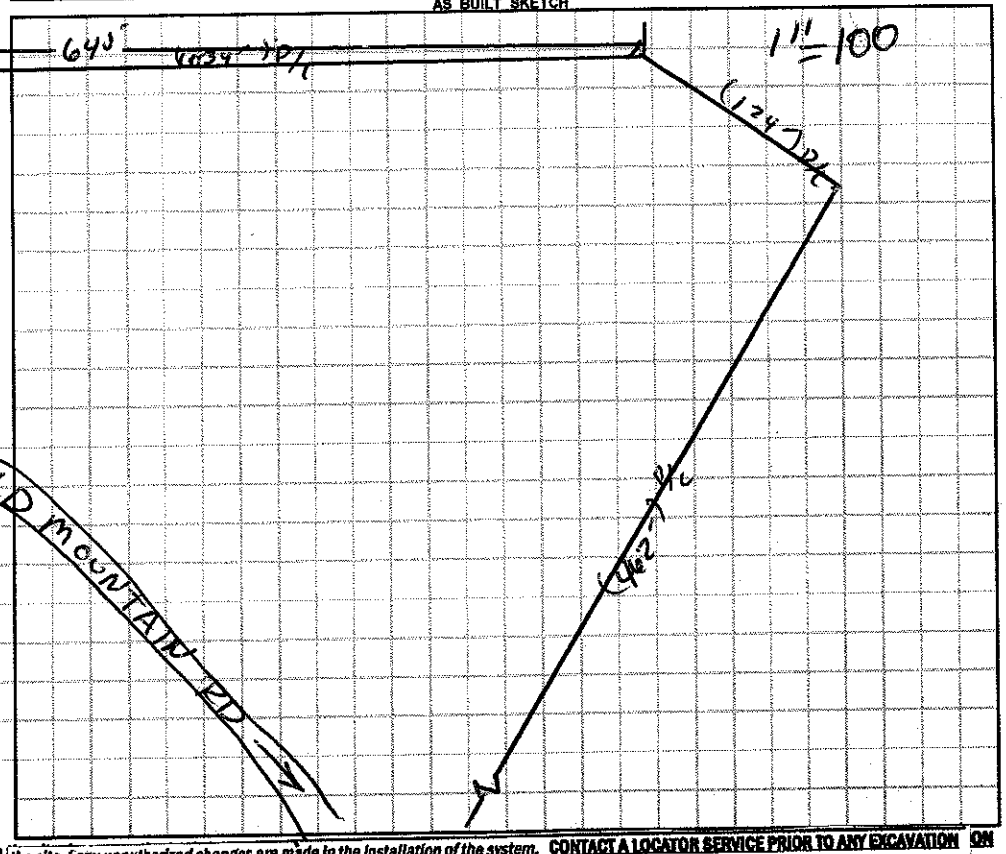

Permit can be suspended or revoked if any false information is supplied toward securing the permit / any unauthorized changes are made to the site / any unauthorized changes are made in the installation of the system. **CONTACT A LOCATOR SERVICE PRIOR TO ANY EXCAVATION** ON no.

[ ] **IMPROVEMENT PERMIT** *with plat valid without expiration.* [X] **IMPROVEMENT PERMIT** *with site plan valid for 60 mos.* [X] **AUTHORIZATION TO CONSTRUCT** *valid for period equal to IMPROVEMENT PERMIT--not to exceed 60 mo.*

Owner / Applicant Signature: Tommy Wingler Date: 10/23/15 Installed by: Tommy Wingler

IMPROVEMENT PERMIT by: David Anthony Date: 10/23/15 OPERATION PERMIT by: W Sparks Date: 10/2/15

AUTHORIZATION TO CONSTRUCT by: David Anthony Date: 10/23/15 Existing System Inspected by: Date:

Health Dept. Copy - WHITE Applicant (Final Approval) - YELLOW Applicant (Conditional Approval) - PINK