
~~Acknowledgement Of~~ Plans Submittal ONLY!

Date 10/23/15

Date 10/23/15

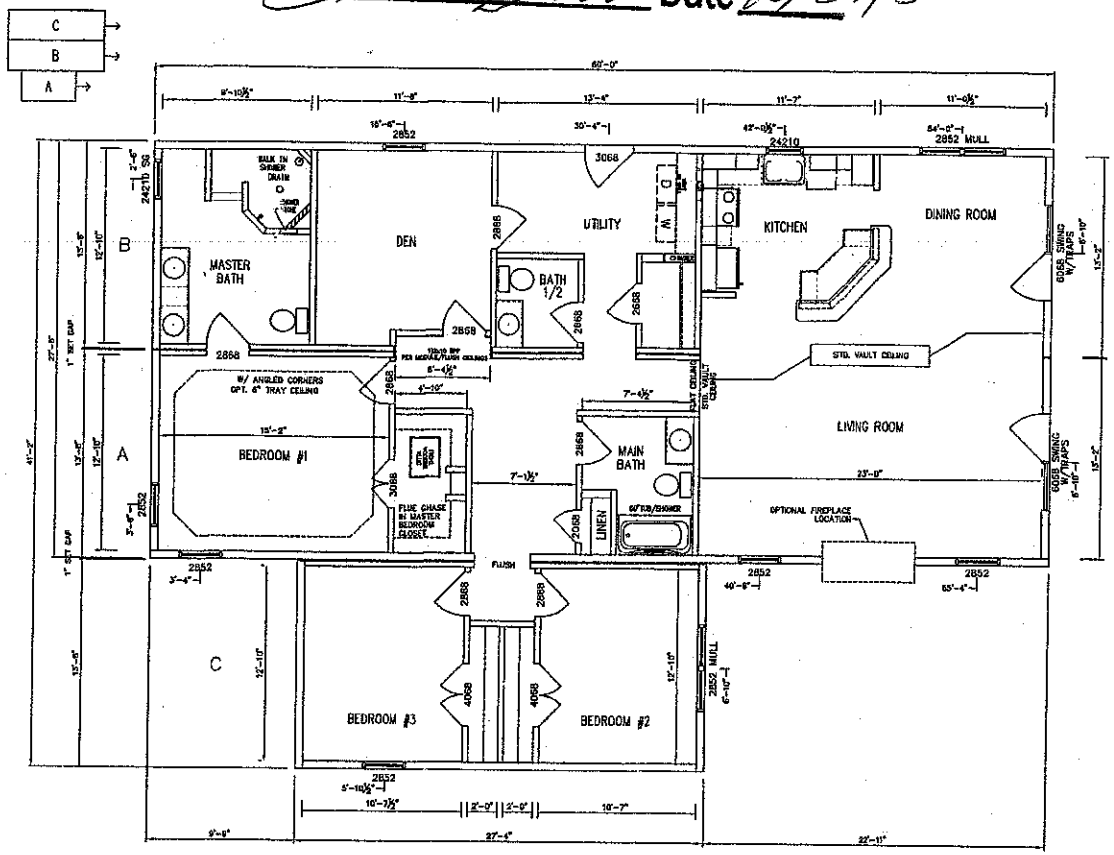

mirrow kitchen + Living room

? foundation for rock for fire place fire place to ceiling for gas logs

~~Roof with 7 pitch height at the ridge at the metal roof.~~

make Box C back to A roof

? Dont want tray ceiling in master bedroom

? could we put Attic Acc in hallway instead of closet (pull down stairs)

COR:	NC5176115
SN:	

RITZ-CRAFT CORPORATION

COPYRIGHT ©..... THIS DOCUMENT AND ITS SUBJECT MATTER CONSTITUTE AN UNPUBLISHED WORK AND IS NOT TO BE REPRODUCED WITHOUT THE WRITTEN PERMISSION OF "RITZ-CRAFT CORPORATION"

PROFESSIONAL ENGINEERING

DATE	DESCRIPTION	BY
09-30-15	PRELIM	PK

BUILDER:	G&G CONSTRUCTION
CUSTOMER:	WOODLAND B — , NC
RC ACT. MGR:	JASON DIXON
MODEL:	WOODLAND B
TITLE:	1ST FLOOR PLAN
SCALE:	1/4"=1'
SHEET:	FP1

SINGLE/DOUBLE HUNG WINDOWS
LVL IS 2.0E W/ Fb=3100 PSI

HVAC system to be supplied and site installed by the purchaser per state and local codes and is subject to inspection by the local jurisdiction. Dwelling to be tested for an air leakage rate of not more than 3 air changes per hour onsite by others. Duct to be tested for leakage onsite by others after installation unless located entirely within the building thermal envelope.

● : NC INSIGNIA
▲ : NTA-F2
■ : DATA SHEET

C:\USERS\BRITTANYM\APPDATA\LOCAL\MICROSOFT\WINDOWS\TEMPORARY INTERNET FILES\CONTENT.OUTLOOK\B6CWZFXR\NC5176115.DWG, Plot Date: 10/2/2015 1:40 PM, by: Brittany Morgenroth