J94

IREDELL COUNTY HEALTH DEPARTMENT

Statesville Phone TR 3-7271 Mooresville Phone NO 3-1271

PERMIT TO INSTALL SEPTIC TANK

Permit Date April 9 1968

Permit NO. _____

Owner Robert Kester Address R6

Installed By C Hoke Address R7


Location of Property 64-70 W - left at Whitcoak Toward Clesta Henkle School - 1 blk on left - Across from Mash Gin Rd. (Rufus Pope home)

Tank		Capacity		Length of Lines		Fixtures	
Block	( )	1000	( )	225'	( )	No. of Baths	( )
Precast	(✓)	1250	(✓)	250'	( )	Dishwasher	( )
		1500	( )	Other 240'		Garbage Grdr.	( )
		Other _____				Other trailer nec	

NOTIFY HEALTH DEPARTMENT AT LEAST EIGHT HOURS BEFORE TANK IS TO BE INSPECTED.

Final Inspection _____ 19__ Approved ( ) Disapproved ( )

Remarks NC well this lot. deep due to lay of land

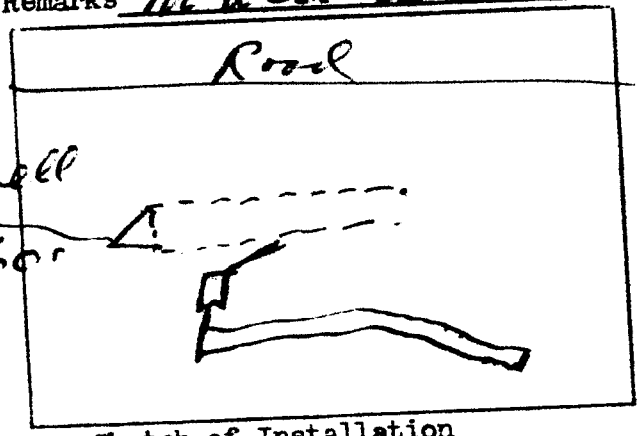

Sketch of Installation

_____

Sanitarian