IREDELL COUNTY HEALTH DEPARTMENT

Statesville Phone TR 3-7271 Mooresville Phone NO 3-1271

PERMIT TO INSTALL SEPTIC TANK

Permit No. 18 Permit Date Dec. 16 1971

Owner Brigida Urgan Cort. E. Pope. R#6. Box 201 Address Statesville

Installed By Charlie Lackey Address Stony Point


Location of Property old Mountain Road going South from white oak Sewer house on left. Second Brick house.

Tank		Capacity		Length of Lines		Fixtures	
Block	( )	1000	(✓)	225'	(✓)	No. of Baths	(1)
Precast	(✓)	1250	( )	250'	( )	Dishwasher	( )
		1500	( )	Other		Garbage Grdr.	( )
		Other				Other	

NOTIFY HEALTH DEPARTMENT AT LEAST EIGHT HOURS BEFORE TANK IS TO BE INSPECTED.

Final Inspection 19 Approved ( ) Disapproved ( )

Remarks 2 lines 5/ft. x 114 ditch.

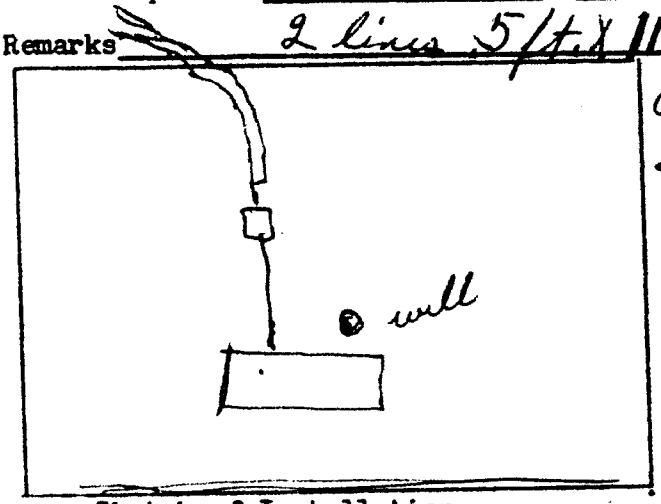

Sketch of Installation

Coite Pope is a plumber & he said put 2 lines in.

Not checked

Sanitarian