IREDELL COUNTY HEALTH DEPARTMENT

STATESVILLE 704-878-5305 MOORESVILLE 704-664-5281

IMPROVEMENT PERMIT / AUTHORIZATION TO CONSTRUCT / OPERATION PERMIT / EXISTING SYSTEM INSPECTION

PERMIT# Repair PIN# ~~4713-42-3149~~ 4713-32-8286 DATE 12/22/03

OWNER OR CONTRACTOR Tony Miller PHONE: Business — Home (704) 873-5994

ADDRESS 238 Cleste-Eufola Rd Statesville N.C. 28677

LOCATION I-40 W, (L) Old Mtn Rd, (R) Cleste-Eufola Rd @ 238 Cleste-Eufola

SUBDIVISION — BLOCK / SECTION — LOT — LOT AREA Acreage SITE CLASS. 05 DESIGN FLOW 360 L.T.A.R. —

Septic Tank: 4000 Gallons; STB 794 Date 11-8-03
Pump Tank: — Gallons; PT — Date —
Pump Make: — Model — Serial No. —
Nitrification Field: No Fields 1 Square Feet Ex Linear Feet Ex
No Lines 3 Trench Width Ex Max Trench Bottom Depth Ex Gravel Depth —

☐ New System ☒ Repair System Type: I (II) III, IV, V, VI
System Description: —
Repair System Description: Gravity Conv.
Maintenance Agreement Required: ☐ Yes ☐ No

☒ House/Mod. Home No. Bedrooms 3
☐ Mobile Home No. Bathrooms 2
☐ Business No. Employees —
☐ Other —


☐ Slab ☐ Crawl Space ☐ Basement w/plumbing ☒ Basement wo/plumbing

Water Supply: ☐ Individual ☒ Public ☐ Community

Comments:/Conditions: ① Pump Crush + Fill Old Septic Tank ② Replace Septic Tank with new filter.


Not to Scale

INITIAL SITE SKETCH

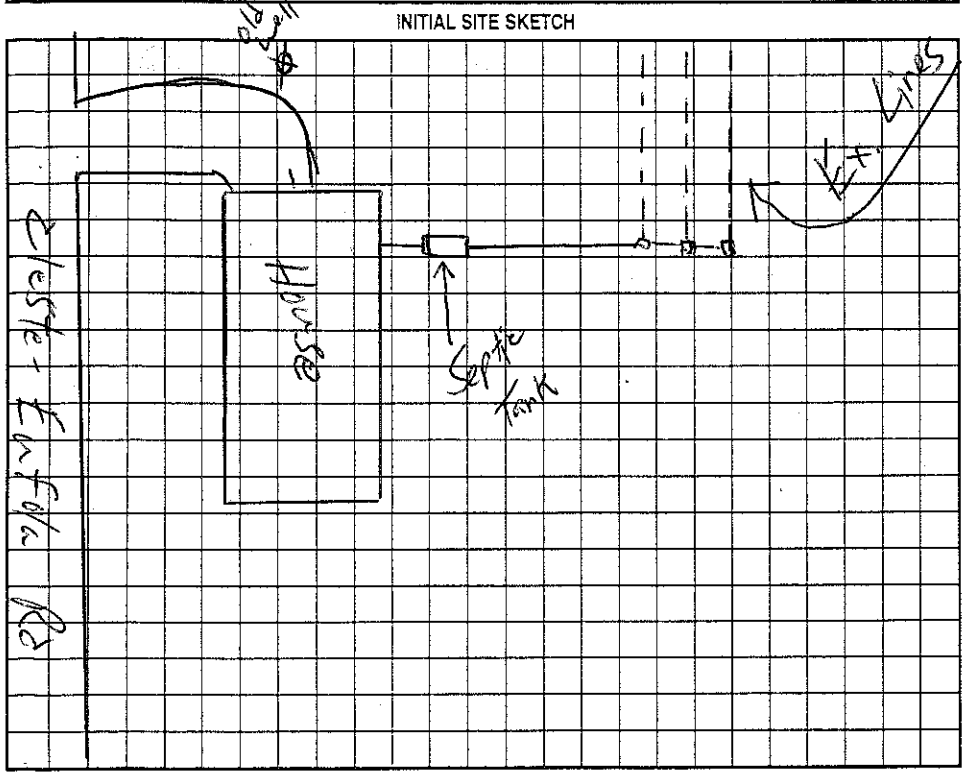

Comments:/Conditions:
- New ST Installed with Zabel Filter
- Septic Tank Risers Installed

AS BUILT SKETCH

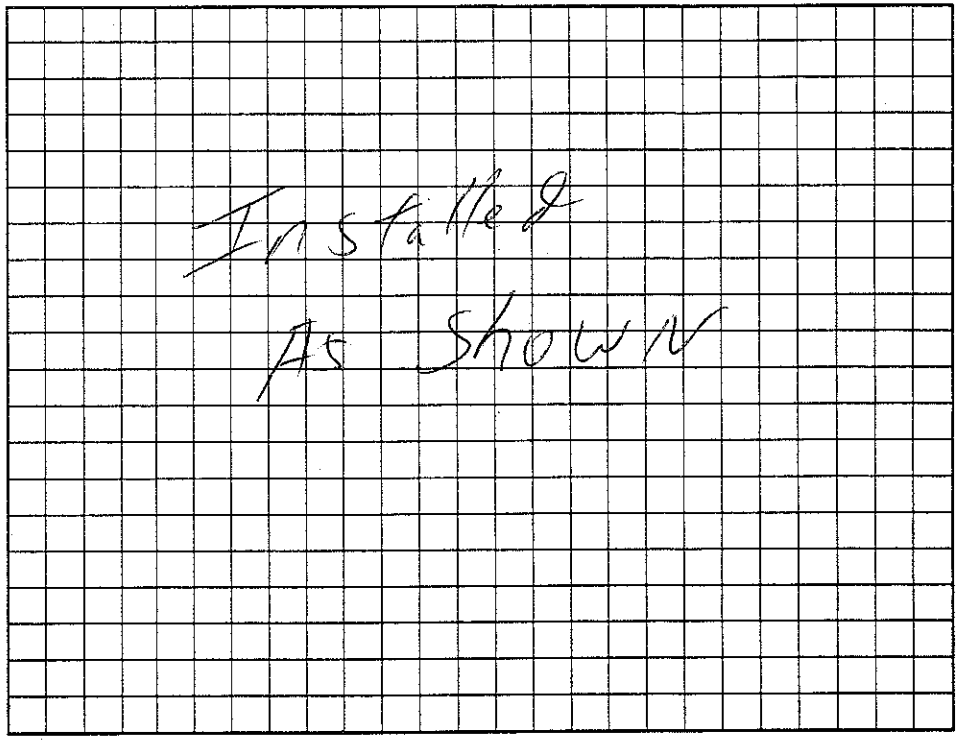

Permit can be suspended or revoked if any false information is supplied toward securing the permit/any unauthorized changes are made to the site/any unauthorized changes are made in the installation of the system. Improvement Permit with plat valid without expiration. Improvement Permit with site plan valid for sixty months. Authorization to Construct is valid for a period equal to that of Improvement Permit – not to exceed sixty months.

Signed: Tony S. Miller date 12-22-03 Installed by: Wes Lytton

Improvement Permit by: William O. Johnson date 12/22/03 Operation Permit by: William O. Johnson date 12/30/03

Authorization to Construct by: William O. Johnson date 12/22/03 Existing System Inspection by: — date —

HEALTH DEPT. COPY: WHITE OWNER COPY (FINAL): YELLOW OWNER COPY (INITIAL): PINK