IREDELL COUNTY HEALTH DEPARTMENT

This Permit Replaces Previous one ISSued 8-1-13 BF

Statesville Office (704) 878-5305 Mooresville Office (704) 660-3625

IMPROVEMENT PERMIT / AUTHORIZATION TO CONSTRUCT / OPERATION PERMIT / EXISTING SYSTEM

PERMIT # 19772

APPLICANT: Todd Sherrill APPLICANT ADDRESS: 1527 Old Mountain Rd PIN # 4713368162

SITE ADDRESS: 1527 Old Mountain Rd PHONE: 704-883-6730 ALT. PHONE: N/A

SITE DIRECTIONS: Hwy 70W TL Old Mountain Rd Property on right beside Celeste Henkel School

SUBDIVISION: N/A SECTION: N/A LOT # N/A LOT AREA: 0.68 acres DESIGN FLOW: 240gpd L.T.A.R.: 0.3

Septic Tank Existing (gal) STB Date
Pump Tank 1000 (gal) PT Date
Pump Make Model Serial #
Nitrification Fields 1 # Lines 4 Linear Ft: 200
Trench Width 36" Max. Trench Bottom Depth 36" Gravel Depth N/A


☐ New System ☑ Repair ☐ Expansion System Type: I II (III) IV V VI
System Description:
Repair System Description: 25% Reduction - Pump
Maintenance Agreement Required: ☐ YES ☑ NO
☐ GRAVITY ☐ PRESSURE

☑ Residence No. Bedrooms 2
☐ Business No. Persons 4
☐ Other No. Employees
☐ Slab ☑ Crawl Space
☐ Basement w/plumbing ☐ Basement w/o plumbing

Water Supply: ☑ Private ☐ Public ☐ Community

Comments / Conditions: Improvements ONLY! Submit [redacted] recorded Easement prior to issuance of CA. Install a 25% Reduction system on contour w/ parallel distribution. Replace septic tank if needed.

INITIAL SITE SKETCH

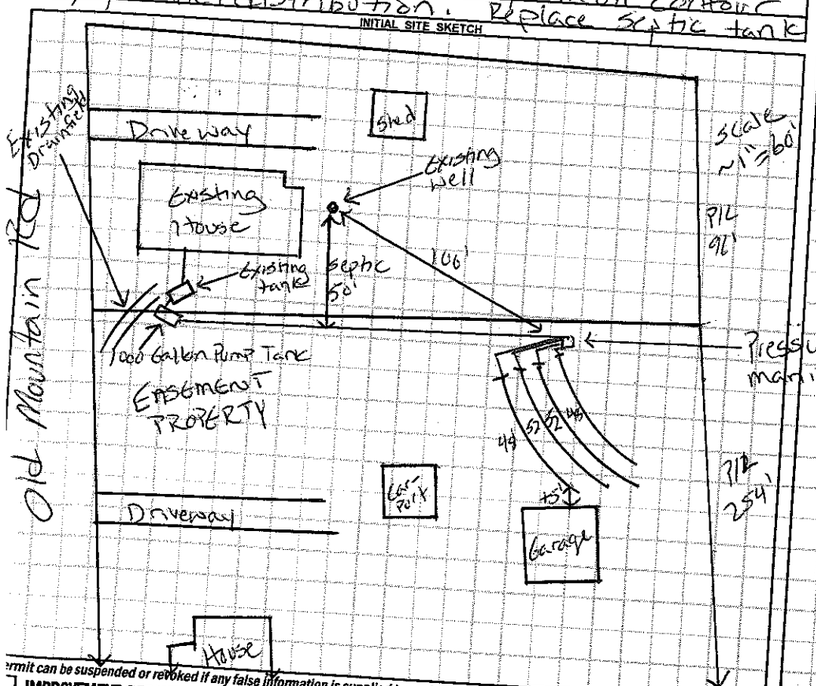

AS BUILT SKETCH

REVOKED

---IMPROVEMENT PERMIT ONLY---

DO NOT ISSUE BUILDING PERMIT!

Submit EASEMENT

Permit can be suspended or revoked if any false information is supplied toward securing the permit / any unauthorized changes are made to the site / any unauthorized changes are made in the installation of the system. CONTACT A LOCATOR SERVICE PRIOR TO ANY EXCAVATION

☐ IMPROVEMENT PERMIT *with plat* valid without expiration. ☐ IMPROVEMENT PERMIT *with site plan* valid for 60 mos. ☐ AUTHORIZATION TO CONSTRUCT valid for period equal to IMPROVEMENT PERMIT--not to exceed 60 mo.

Owner / Applicant Signature: Todd A Sherrill Date: Installed by:

IMPROVEMENT PERMIT by: Justin Henderson Date: 4-24-14 OPERATION PERMIT by: Date:

AUTHORIZATION TO CONSTRUCT by: Date: Existing System Inspected by: Date:

Health Dept. Copy - WHITE Applicant (Final Approval) - YELLOW Applicant (Conditional Approval) - PINK