IREDELL COUNTY HEALTH DEPARTMENT

Statesville Phone TR 3-7271 Mooresville Phone NO 3-1271

PERMIT TO INSTALL SEPTIC TANK

Permit NO. _____ Permit Date OCT 18 1960

Owner CHARLES TRAVIS (STONE 38) Address STATESVILLE R.F.D.

Installed By OSTWALT Address _____


Location of Property OFF #70 WEST AT WHITE OAK SERVICE STA. BEFORE CELEST HENKLE SCHOOL - 2 LEFT - 1 MILE BRICK (GRAY) RANCH

Tank		Capacity		Length of Lines		Fixtures	
Block	(✓)	800	( )	150'	( )	No. of Baths	(1½)
Precast	( )	900	( )	175'	( )	Dishwasher	( )
		1000	(✓)	200'	( )	Garbage Grdr.	( )
		1100	( )	225'	(✓)	Auto-Washer	( )
		1200	( )	250'	( )	Other	_____
		Other	_____	Other	_____		

NOTIFY HEALTH DEPARTMENT AT LEAST EIGHT HOURS BEFORE TANK IS TO BE INSPECTED.

Final Inspection Oct 16 19 60 Approved (✓) Disapproved ( )

Remarks 6' x 6'

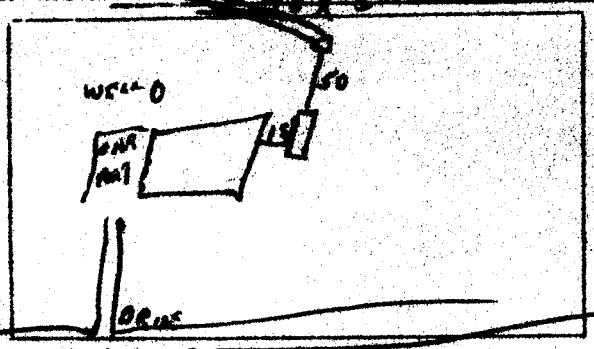

Sketch of Installation

Rufus G. Thomas

Sanitarian