IREDELL COUNTY HEALTH DEPARTMENT

Statesville Phone TR 3-7271 Mooresville Phone NO 3-1271

PERMIT TO INSTALL SEPTIC TANK

Permit NO._____ Permit Date MAY 14 195_

Owner E.D DEAL Address CELESTE HENKEE

Installed By R.C OSTWALT Address_____


Location of Property PASSED CELEST H.S. 1st new BRICK HOUSE ON RIGHT

Tank		Capacity		Length of Lines		Fixtures	
Block	(✓)	800	( )	150'	( )	No. of Baths	(1)
Precast	( )	900	( )	175'	( )	Dishwasher	(1)
		1000	(✓)	200'	( )	Garbage Grdr.	( )
		1100	( )	225'	(✓)	Auto-Washer	( )
		1200	( )	250'	( )	Other_____	
		Other_____		Other_____			

NOTIFY HEALTH DEPARTMENT AT LEAST EIGHT HOURS BEFORE TANK IS TO BE INSPECTED.

Final Inspection MAY 14 1958 Approved (✓) Disapproved ( )

Remarks_____

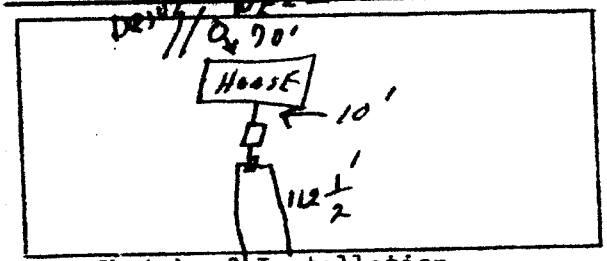

Sketch of Installation

Raford G. Holmes

Sanitarian