IREDELL COUNTY HEALTH DEPARTMENT

STATESVILLE 704-878-5305 MOORESVILLE 704-664-5281

IMPROVEMENT PERMIT / AUTHORIZATION TO CONSTRUCT / OPERATION PERMIT / EXISTING SYSTEM INSPECTION

PERMIT# 73664 PIN# 4713 41 2608 DATE 8-6-98

OWNER OR CONTRACTOR April Sharpe PHONE: Business Home 213 7471

ADDRESS 516 D River Hwy Mooresville, N.C.

LOCATION Old mtn Rd Turn celeste Enfold Rd .6 mi left.

SUBDIVISION BLOCK / SECTION LOT LOT AREA 3 acres SITE CLASS. PS DESIGN FLOW 480 L.T.A.R. .3

Septic Tank: 1000 Gallons; STB 238 Date 2-1-98
Pump Tank: Gallons; PT Date
Pump Make: Model Serial No.
Nitrification Field: No Fields 1 Square Feet 1600 Linear Feet 533
No Lines 4 Trench Width 36" Max Trench Bottom Depth 36" Gravel Depth 12"

☑ New System ☐ Repair System Type: I, II, III, IV, V, VI
System Description: Conv. Gravity
Repair System Description: Pump to Conv.
Maintenance Agreement Required: ☐ Yes ☐ No


☐ House/Mod. Home No. Bedrooms 4
☑ Mobile Home No. Bathrooms 2
☐ Business No. Employees
☐ Other

☐ Slab ☑ Crawl Space ☐ Basement w/plumbing ☐ Basement wo/plumbing

Water Supply: ☐ Individual ☑ Public ☐ Community


Comments:/Conditions:

INITIAL SITE SKETCH

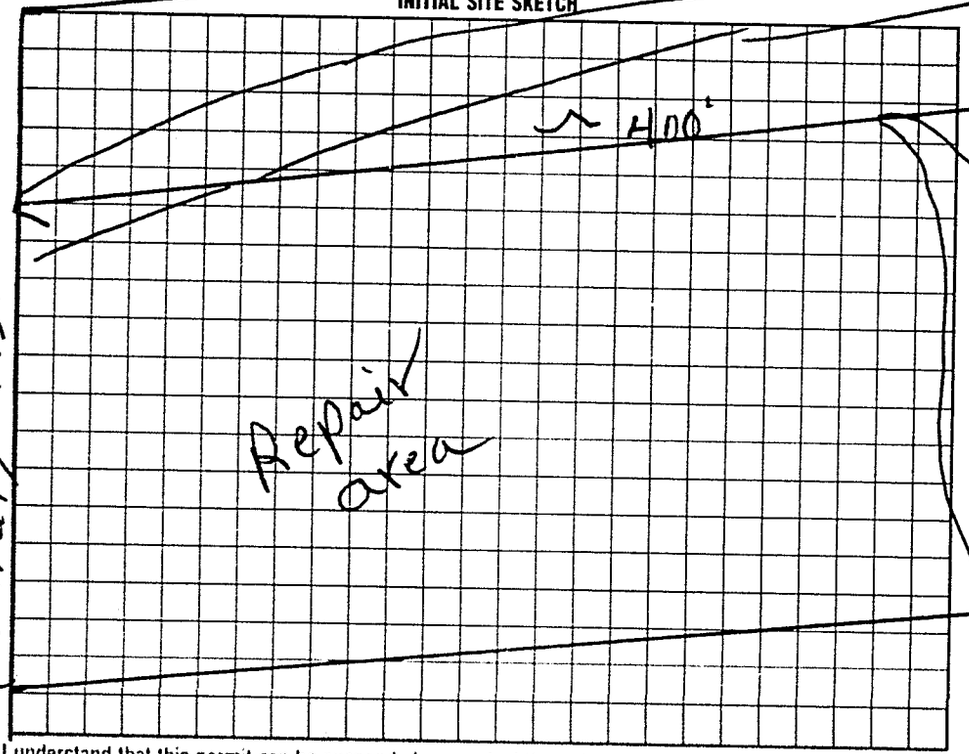

Comments:/Conditions:

AS BUILT SKETCH

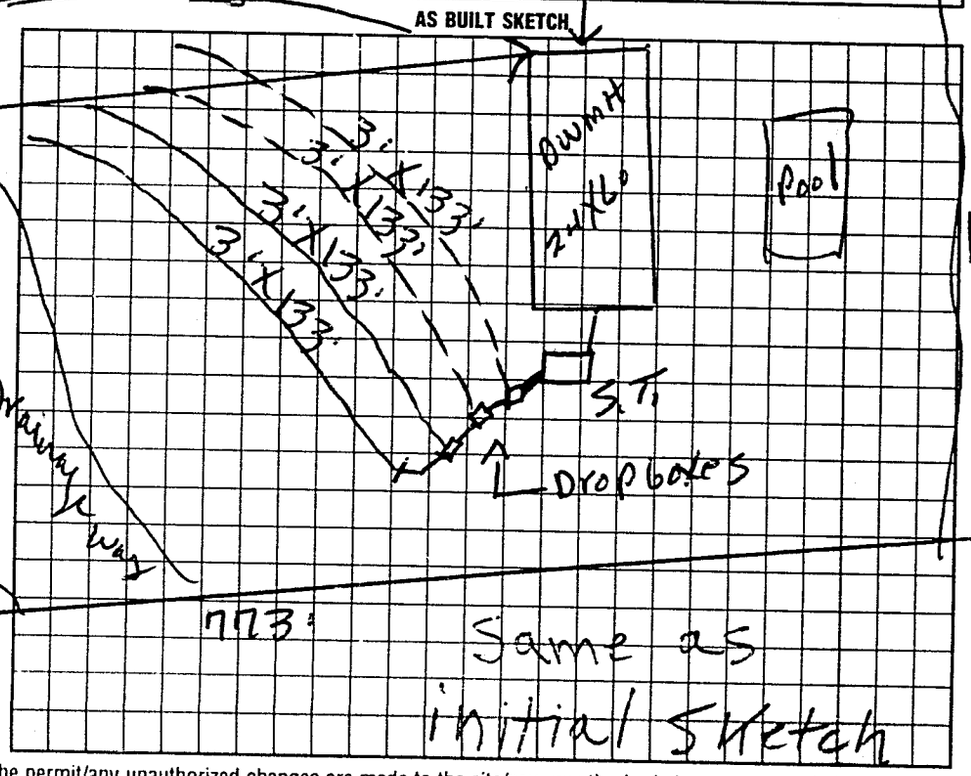

I understand that this permit can be suspended or revoked if any false information is supplied toward securing the permit/any unauthorized changes are made to the site/any unauthorized changes are made in the installation of the system. Improvement Permit with plat valid without expiration. Improvement Permit with site plan valid for sixty months. Authorization to Construct is valid for a period equal to that of Improvement Permit – not to exceed sixty months.

Signed: April D. Sharpe date

Improvement Permit by: P. C. Moore date 8-6-98

Authorization to Construct by: P. C. Moore date 8-6-98

Installed by: H. B. Salmon

Operation Permit by: P. C. Moore date 10-2-98

Existing System Inspection by date

HEALTH DEPT. COPY (WHITE) INSPECTION COPY (FINAL) GREEN OWNER COPY (FINAL) YELLOW INSPECTION COPY (INITIAL) PINK OWNER COPY (INITIAL) GOLD