DEBBIE Williams UNPAID FEE'S NO 395 PAID

IREDELL COUNTY HEALTH DEPARTMENT

STATESVILLE 704-878-5305 MOORESVILLE 704-664-5281

IMPROVEMENT PERMIT / AUTHORIZATION TO CONSTRUCT / OPERATION PERMIT / EXISTING SYSTEM INSPECTION

PERMIT# 142422 PIN# 4713 41 8079 9022 DATE 5-23-07

OWNER OR APPLICANT AMERICAS NOW PLACE, INC PHONE: Business 704-746-7094 Home 704-664-5800

ADDRESS 168-D NORMAN STATION BLVD, MOORESVILLE, NC 28117

LOCATION OLD MOUNTAIN ROAD TO BLACK ROAD, 0.8 MILE ON RIGHT

SUBDIVISION CARITA SHERRILL BLOCK / SECTION ____ LOT 2 LOT AREA 0.945 ACRES SITE CLASS. P3 DESIGN FLOW 360 L.T.A.R. 0.35 GPD/FT²

Septic Tank: 1000 Gallons; STB 1007 Date 5-22-07

Pump Tank: ____ Gallons; PT ____ Date ____

Pump Make: ____ Model ____ Serial No. ____

Nitrification Field: No Fields 1 Square Feet 1040 Linear Feet 260'

No Lines THREE Trench Width 36" Max Trench Bottom Depth 36" Gravel Depth N/A

☒ New System ☒ Repair ☐ Expansion System Type: I (II) III IV V VI

System Description: 25% REDUCTION, GRAVITY

Repair System Description: 25% REDUCTION, PUMP

Maintenance Agreement Required: ☐ Yes ☒ No

☒ House/Mod. Home ☐ Mobile Home ☐ Business ☐ Other

No. Bedrooms 3 No. Persons ____ No. Employees ____


Water Supply: ☐ Individual ☒ Public ☐ Community

☐ Gravity ☐ Pressure ☐ Slab ☒ Crawl Space ☐ Basement w/plumbing ☐ Basement wo/plumbing


Comments/Conditions: INSTALL 25% REDUCTION SYSTEM ON CONTOUR NO DEEPER THAN 36" - STUB-OUT PLUMBING AS HIGH AS POSSIBLE. PRIVATE DRIVEWAY

Comments/Conditions: Brown Fill

INITIAL SITE SKETCH ~ SCALE: 1" = 60'

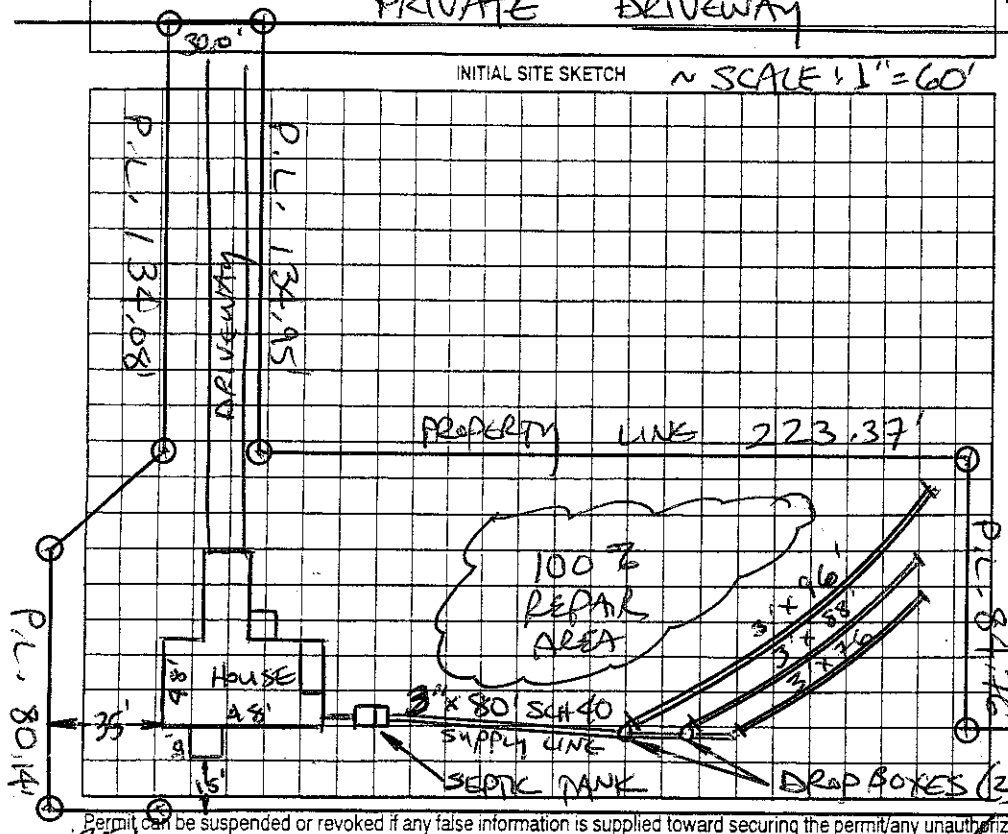

AS BUILT SKETCH

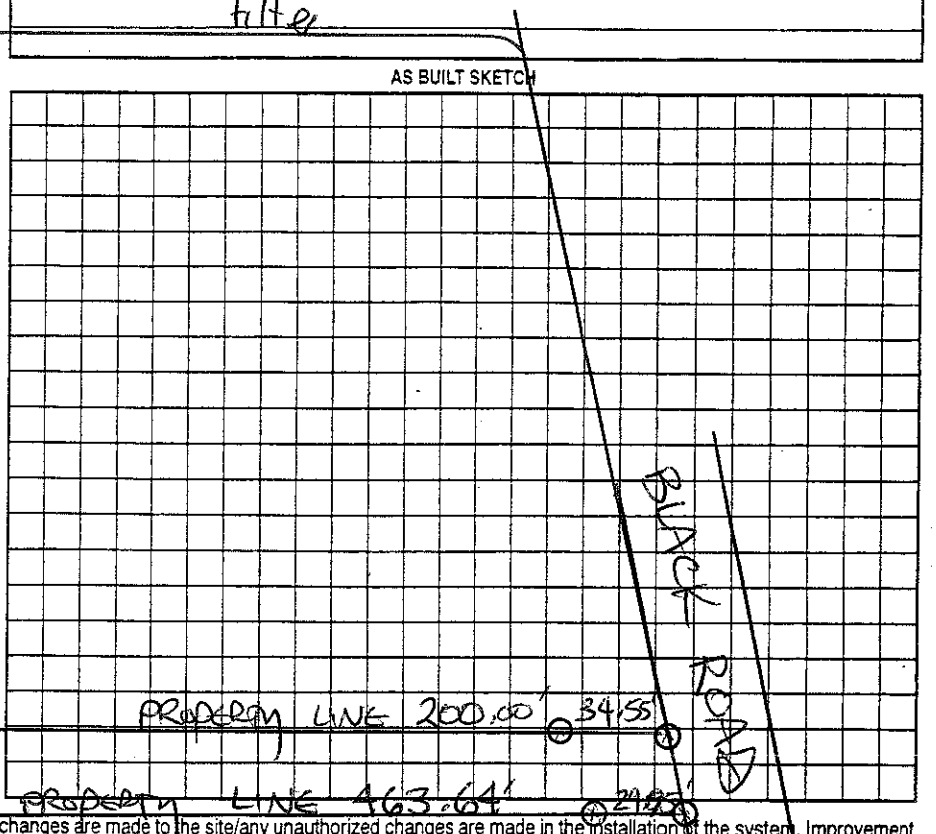

Permit can be suspended or revoked if any false information is supplied toward securing the permit/any unauthorized changes are made to the site/any unauthorized changes are made in the installation of the system. Improvement Permit with plat valid without expiration ☐ Improvement Permit with site plan valid for sixty months ☒ Authorization to Construct is valid for a period equal to that of Improvement Permit – not to exceed sixty months.

Signed: X Carol Hallum date 5-23-07 Installed by: K & M Grading

Improvement Permit by: STEVE HEDRICK date 5-23-07 Operation Permit by: ____ date 7-3-07

Authorization to Construct by: STEVE HEDRICK date 5-23-07 Existing System Inspection by: ____ date ____

HEALTH DEPT. COPY: WHITE OWNER COPY (FINAL): YELLOW OWNER COPY (INITIAL): PINK