IREDELL COUNTY HEALTH DEPARTMENT

Statesville Office (704) 878-5305 Mooresville Office (704) 660-3625 PERMIT # 213172

IMPROVEMENT PERMIT / AUTHORIZATION TO CONSTRUCT / OPERATION PERMIT / EXISTING SYSTEM

PIN # 4713443496

APPLICANT: Barton E Johnson APPLICANT ADDRESS: 122 Celeste Eufola Rd Statesville NC

SITE ADDRESS: 122 Celeste Eufola Rd Statesville NC PHONE: 704-402-0988 ALT. PHONE: N/A

SITE DIRECTIONS: I 40 W to old mtn Rd T/L then T/R on Celeste Eufola lot on right

SUBDIVISION: N/A SECTION: N/A LOT # N/A LOT AREA: 1.509ac DESIGN FLOW: Ex L.T.A.R.: Ex


Septic Tank	Ex (gal)	STB	Date	☐ New System	☐ Repair	☐ Expansion	System Type: I ☒ II III IV V VI	☒ Residence	No. Bedrooms Ex
Pump Tank	(gal)	PT	Date	System Description: Existing				☐ Business	No. Persons Ex
Pump Make	Model		Serial #	Repair System Description:				☐ Other	No. Employees
# Nitrification Fields	Ex # Lines Ex		Linear Ft: Ex	Maintenance Agreement Required:	☐ YES	☒ NO		☐ Slab	☒ Crawl Space
Trench Width	Ex Max. Trench Bottom Depth Ex		Gravel Depth Ex		☑ GRAVITY	☐ PRESSURE		☐ Basement w/plumbing	☐ Basement w/o plumbing

Water Supply: ☐ Private ☒ Public ☐ Community

Comments / Conditions: All pools must be 15' from any part of STS

INITIAL SITE SKETCH

AS BUILT SKETCH

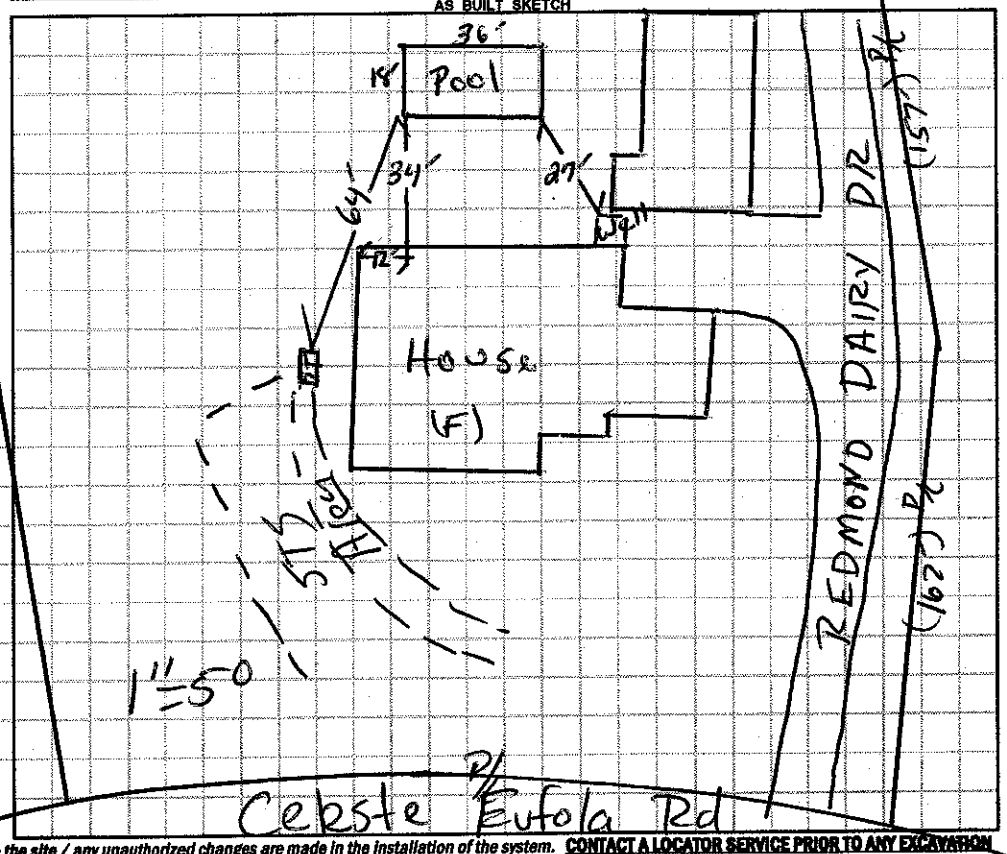

Permit can be suspended or revoked if any false information is supplied toward securing the permit / any unauthorized changes are made to the site / any unauthorized changes are made in the installation of the system. **CONTACT A LOCATOR SERVICE PRIOR TO ANY EXCAVATION**

☐ **IMPROVEMENT PERMIT** *with plat valid without expiration.* ☐ **IMPROVEMENT PERMIT** *with site plan valid for 60 mos.* ☐ **AUTHORIZATION TO CONSTRUCT** *valid for period equal to IMPROVEMENT PERMIT--not to exceed 60 mo.*

Owner / Applicant Signature: Barton E. Johnson Date: 10/5/15 Installed by:

IMPROVEMENT PERMIT by: Date: OPERATION PERMIT by: Date:

AUTHORIZATION TO CONSTRUCT by: Date: Existing System Inspected by: Date: 09/24/15

Health Dept. Copy - WHITE Applicant (Final Approval) - YELLOW Applicant (Conditional Approval) - PINK