IREDELL COUNTY HEALTH DEPARTMENT

Statesville Phone TR 3-7271 Mooresville Phone NO 3-1271

PERMIT TO INSTALL SEPTIC TANK

Permit NO. _____ Permit Date May 6 19 60

Owner R.C. Johnston Jr. CLYDE HOKE Address Cleste

Installed By C Hoke owner Address R7 Taylorsville Cafe Rd


Location of Property Our 1005 to 1368 - left 2nd on left. Cleste Henkel School Rd

Tank		Capacity		Length of Lines		Fixtures	
Block	( )	800	( )	150'	( )	No. of Baths	( )
Precast	( )	900	( )	175'	( )	Dishwasher	( )
		1000	( )	200'	( )	Garbage Grdr.	( )
		1100	( )	225'	( )	Auto-Washer	( )
		1200	( )	250'	( )	Other	
		Other		Other			

NOTIFY HEALTH DEPARTMENT AT LEAST EIGHT HOURS BEFORE TANK IS TO BE INSPECTED.

Final Inspection _____ 19___ Approved ( ) Disapproved ( )

Remarks Repair 100 ft.

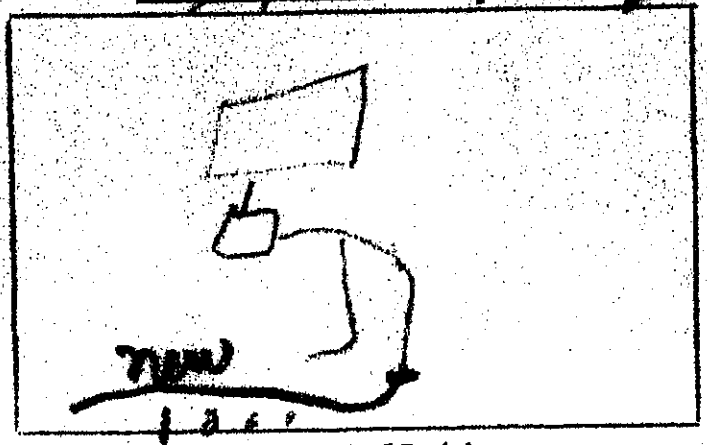

Sketch of Installation

Location of the proposed exterior closet addition does not appear to impact the existing on-site septic system.**NOTE:

REHS

Date: 2-24-12

ICHD-Environmental Health Division

RQ.2

Sanitarian

E-MAILED 2/24/12 db BS @ 2:49 p