IREDELL COUNTY HEALTH DEPARTMENT

STATESVILLE 704-878-5305 — MOORESVILLE 704-664-5281

IMPROVEMENT PERMIT / AUTHORIZATION TO CONSTRUCT / OPERATION PERMIT / EXISTING SYSTEM INSPECTION

2⁰⁰ Huddler

PERMIT# 72872 PIN# 4713 45 4648

OWNER OR CONTRACTOR Bethlehem United methodist PHONE: Business 872 1603 Home

DATE 4-17-98

ADDRESS 607 Bethlehem Rd Sta

LOCATION Turn off I-40 on old nctn To left Then TL Bethlehem Rd 1st ch Rt,

SUBDIVISION BLOCK / SECTION LOT LOT AREA 4acre + SITE CLASS. PS DESIGN FLOW 725 L.T.A.R. .35

Septic Tank: 1550 Gallons; STB 268 Date 2-28-98

Pump Tank: Gallons; PT Date

Pump Make: Model Serial No.

Nitrification Field: No Fields 1 Square Feet 2100 Linear Feet 700

No Lines 5 Trench Width 36" Max Trench Bottom Depth 36" Gravel Depth 12"

☑ New System ☐ Repair System Type: I, II, III, IV, V, VI

System Description: Conv. Gravity

Repair System Description:

Maintenance Agreement Required: ☐ Yes ☑ No

☐ House/Mod. Home No. Bedrooms

☐ Mobile Home No. Bathrooms

☐ Business No. Employees

☑ Other Church 145 Seats


☑ Slab ☐ Crawl Space ☐ Basement w/plumbing ☐ Basement wo/plumbing

Water Supply: ☐ Individual ☑ Public ☐ Community


Comments:/Conditions: Affix New Bldg To church & replacing old S.T. System with New one as shown for entire Church Complex

Comments:/Conditions: * System installed during light/med Rain - Covered while being inspected

INITIAL SITE SKETCH

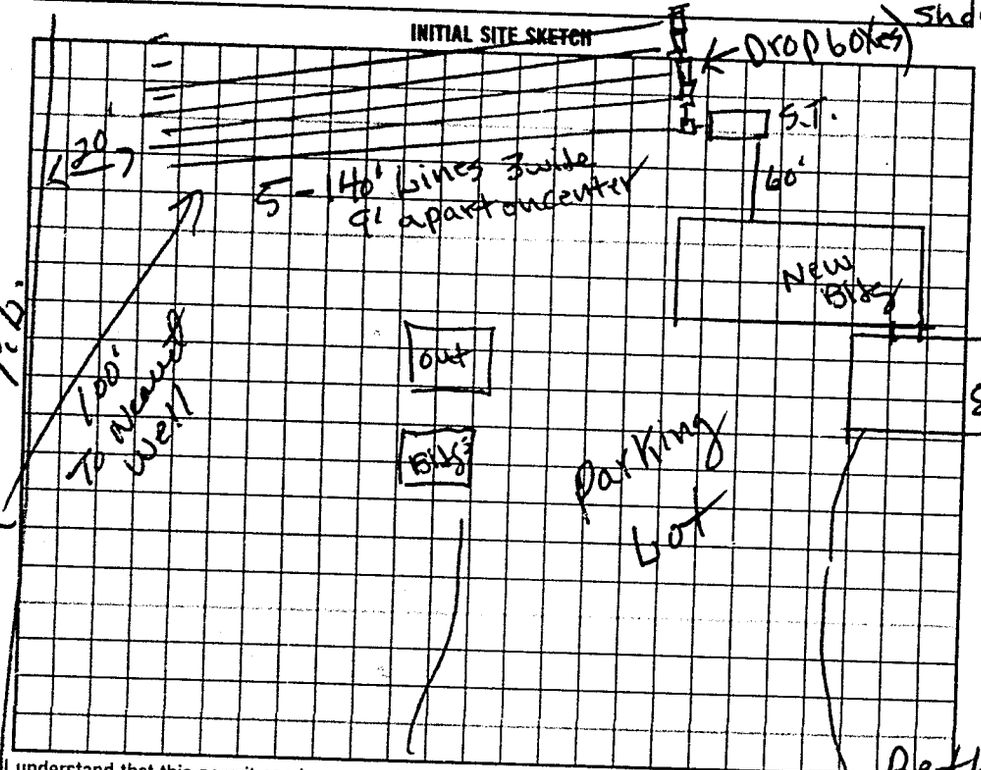

AS BUILT SKETCH

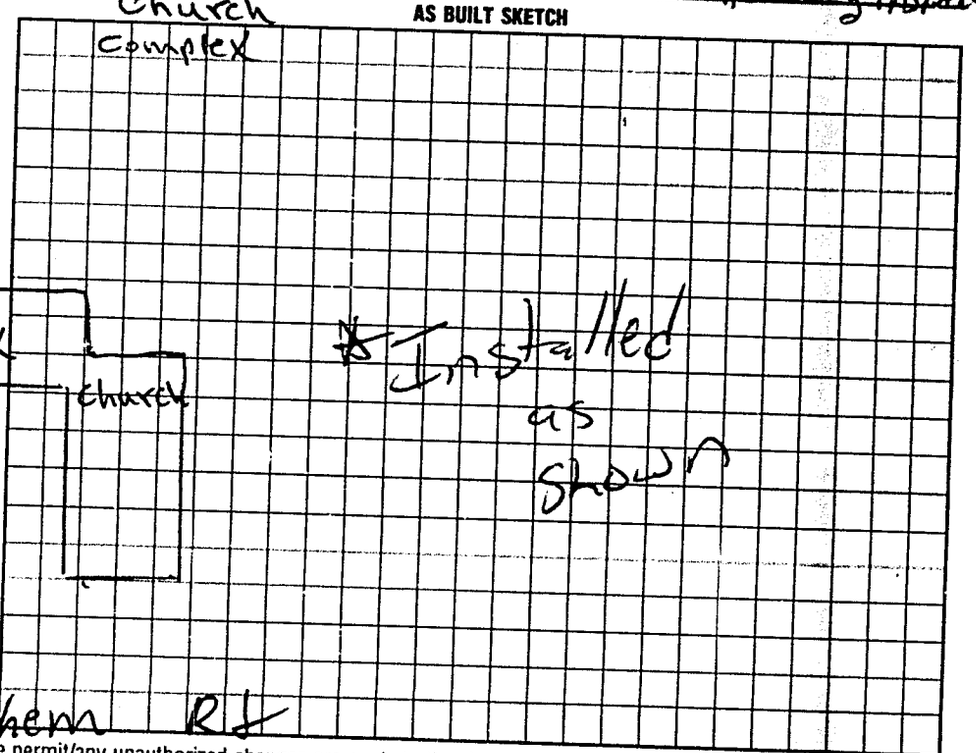

I understand that this permit can be suspended or revoked if any false information is supplied toward securing the permit/any unauthorized changes are made to the site/any unauthorized changes are made in the installation of the system. Improvement Permit with plat valid without expiration. Improvement Permit with site plan valid for sixty months. Authorization to Construct is valid for a period equal to that of Improvement Permit – not to exceed sixty months.

Signed: L.B. Woods date 4-29-98

Improvement Permit by: P.C. Moore date 4-17-98

Authorization to Construct by: P.C. Moore date 4-17-98

Installed by: James Huddler

Operation Permit by: Mark Collins date 4-30-98

Existing System Inspection by: date

HEALTH DEPT COPY: WHITE — INSPECTION COPY (FINAL): GREEN — OWNER COPY (FINAL): YELLOW — INSPECTION COPY (INITIAL): PINK — OWNER COPY (INITIAL): GOLD