3:30

IREDELL COUNTY HEALTH DEPARTMENT - *ENVIRONMENTAL HEALTH* ☑ STATESVILLE OFFICE 704-878-5305 ☐ MOORESVILLE OFFICE 704-664-5281

IMPROVEMENT PERMIT (a) / AUTHORIZATION TO CONSTRUCT (a) / OPERATION PERMIT (1) / EXISTING SYSTEM INSPECTION

PERMIT # 168623 PIN # 4713-46-0287 DATE 4 October 2011

OWNER Brian Wolf APPLICANT: PHONE: Home/Cell # (704) 928-5295 Business #

SITE ADDRESS 106 Belinda Lp. Statesville OWNER / APPLICANT ADDRESS

SITE DIRECTIONS Intersection of Old Mtn. Rd AND Belinda Lp.

SUBDIVISION BLOCK / SECTION LOT # LOT AREA 0.46ac. DESIGN FLOW 360 g/d L.T.A.R. 0.25 g/ft²/d

Septic Tank 1000 Gallons: STB 760 Date 7-28-11
Pump Tank Gallons: P T Date
Pump Make Model Serial #
No. Nitrification Fields: 1 No. Lines 6 Linear Feet 240
Trench Width 24" Max. Trench Bottom Depth 36" Gravel Depth NA

☑ New System ☐ Repair ☐ Expansion System Type I II (III) IV V VI
System Description: 50% Reduction System
Repair System Description: * Maximum Feasible Area
Maintenance Agreement Required ☐ YES ☑ NO
☑ GRAVITY ☐ PRESSURE


☑ Residence No. Bedrooms 3
☐ Business No. Persons
☐ Other No. Employees
☐ Slab ☑ Crawl Space
☐ Basement w/plumbing ☐ Basement w/o plumbing

Water Supply: ☐ Private ☑ Public ☐ Community

Comments / Conditions * Honor all setbacks and zoning requirments.
Tot Panel system with 54 total panels - 9 panels each line.

* Property recorded 1955 - [redacted]
* Pool/lock Fence

INITIAL SITE SKETCH

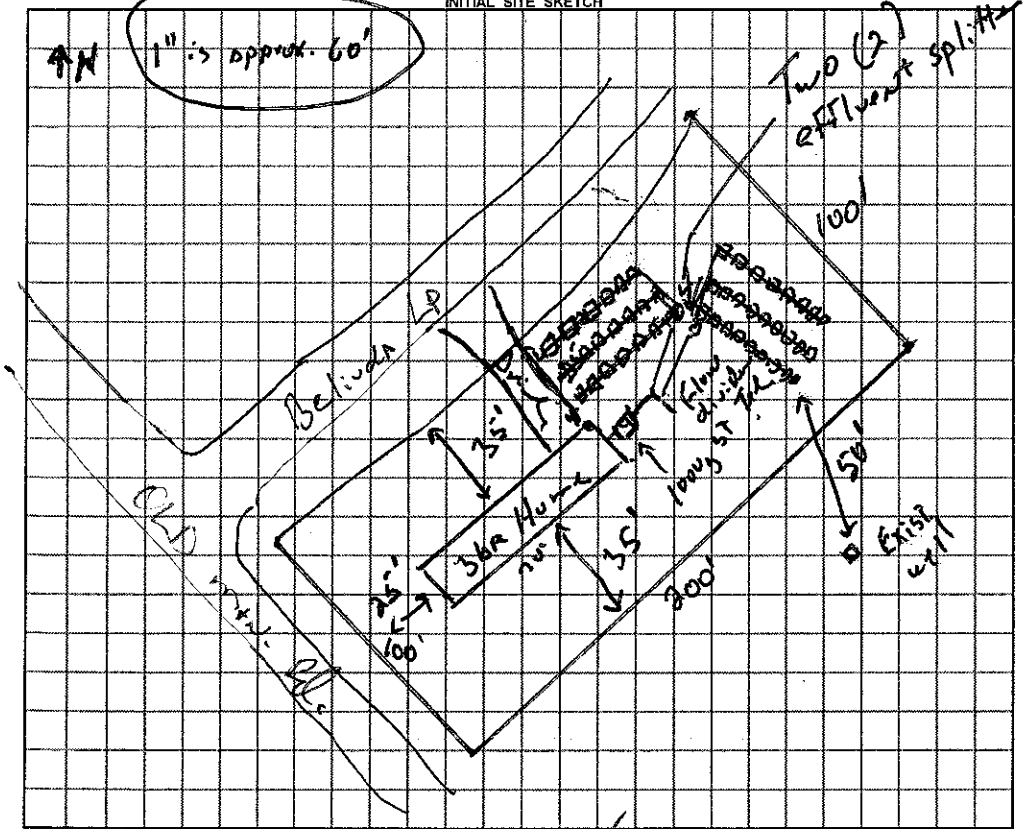

AS BUILT SKETCH

Installed as Drawn

Permit can be suspended or revoked if any false information is supplied toward securing the permit / any unauthorized changes are made to the site / any unauthorized changes are made in the installation of the system.

☐ *IMPROVEMENT PERMIT* with plat valid without expiration. ☑ *IMPROVEMENT PERMIT* with ~~plat valid without expiration~~ site plan valid 60 mo. ☑ *AUTHORIZATION TO CONSTRUCT* valid for period equal to IMPROVEMENT PERMIT--not to exceed 60 mo.

Owner / Applicant Signature: Date 1-18-12 Installed by: A-1 Backhoe

IMPROVEMENT PERMIT by: REHS Date 3 Jan. 12 OPERATION PERMIT by: REHS Date 30 Jan. 12

AUTHORIZATION TO CONSTRUCT by: REHS Date 23 Jan. 12 Existing System Inspected by: REHS Date

YOU SHOULD CONTACT A LOCATOR SERVICE PRIOR TO ANY EXCAVATION

White Copy – Environmental Health YELLOW COPY (Final) Owner / Applicant PINK COPY (Initial) Owner / Applicant