IREDELL COUNTY HEALTH DEPARTMENT

Statesville Phone TR 3-7271 Mooresville Phone NO 3-1271

PERMIT TO INSTALL SEPTIC TANK

Permit NO. _____ Permit Date 5-19 1960

Owner C. L. Travis Jr. Address Cleveland Co.

Installed By Clyde Hoke Address R 7


Location of Property _____

Tank		Capacity		Length of Lines		Fixtures	
Block	( )	800	( )	150'	( )	No. of Baths	(4)
Precast	(✓)	900	(✓)	175'	( )	Dishwasher	( )
Lock		1000	( )	200'	( )	Garbage Grdr.	( )
		1100	( )	225'	( )	Auto-Washer	( )
		1200	( )	250'	( )	Other	_____
		Other	_____	Other	1000		

NOTIFY HEALTH DEPARTMENT AT LEAST EIGHT HOURS BEFORE TANK IS TO BE INSPECTED.

Final Inspection 5/9 1960 Approved ( ) Disapproved ( )

Remarks Not for washer no wash

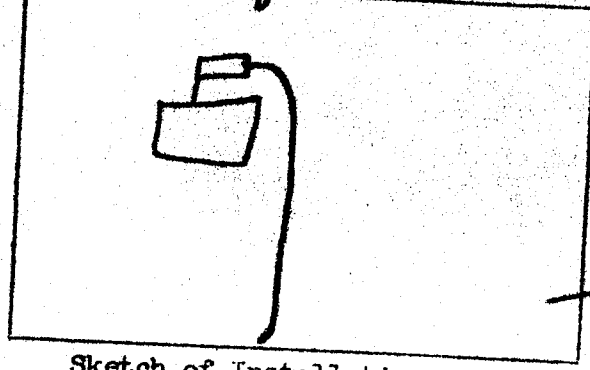

Sketch of Installation

owner states this is only a weekend cottage if ever changes to home will add more lines

Rufford A Thomas

Sanitarian