60045

IREDELL COUNTY HEALTH DEPARTMENT

STATESVILLE 704-878-5305 MOORESVILLE 704-664-5281

IMPROVEMENT PERMIT / CERTIFICATE OF COMPLETION / OPERATION PERMIT / EXISTING SYSTEM INSPECTION

PROPERTY DESCRIPTION NO. 23269 DATE 3-18-96 TAX MAP NO. 8A - A - 55 PT 06 Watershed: ☑ Yes ☐ No

OWNER OR CONTRACTOR Scott Bass PHONE: Business _____ Home 872-3681 WSIV - PA

ADDRESS 208 Heritage Rd Statesville N.C.

LOCATION Old main RD Turn on Celeste Eufola TO Black Rd 3/4 mi left

SUBDIVISION _____ BLOCK / SECTION _____ LOT _____ LOT AREA 1 acre SITE CLASS P5 DESIGN FLOW 360 L.T.A.R. .3

Septic Tank: 1000 Gallons; STB 794 Date 5-24-96
Pump Tank: _____ Gallons; PT _____ Date _____
Pump Make: _____ Model _____ Serial No _____
Nitrification Field: No Fields 1 Square Feet 1200 Linear Feet 400
No Lines 5 Trench Width 36 Max Trench Bottom Depth 36 Gravel Depth 12"

☑ New System ☐ Repair System Type: I II III IV V VI
System Description: Conv. Gravity
Repair System Description: Pump to ~~Gravity~~ Panels
Maintenance Agreement Required: Yes No


☑ House/Mod. Home No. Bedrooms 3
☐ Mobile Home No. Bathrooms 2
☐ Business No Employees _____
☐ Other _____
☐ Slab ☐ Crawl Space ☑ Basement w/plumbing ☐ Basement wo/plumbing

Water Supply:
☐ Individual
☐ Community
☑ Public

Comments:


Comments:

INITIAL SITE SKETCH 225'

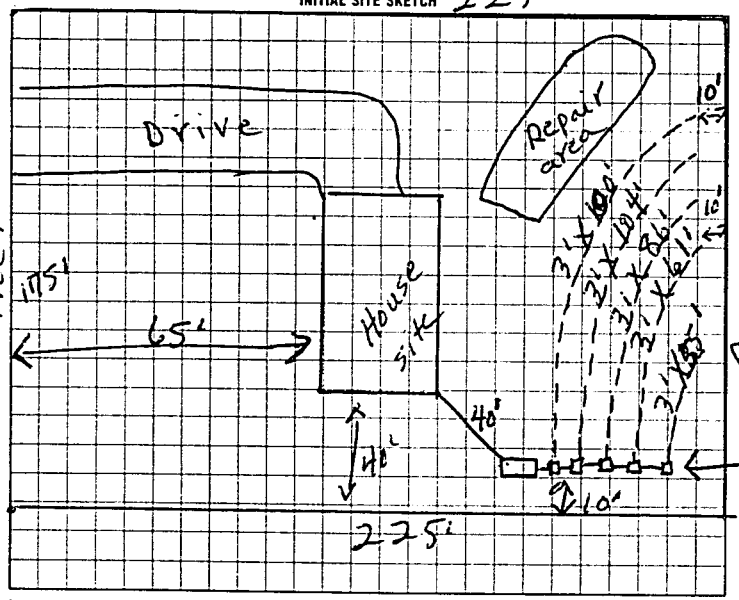

Street X

AS BUILT SKETCH

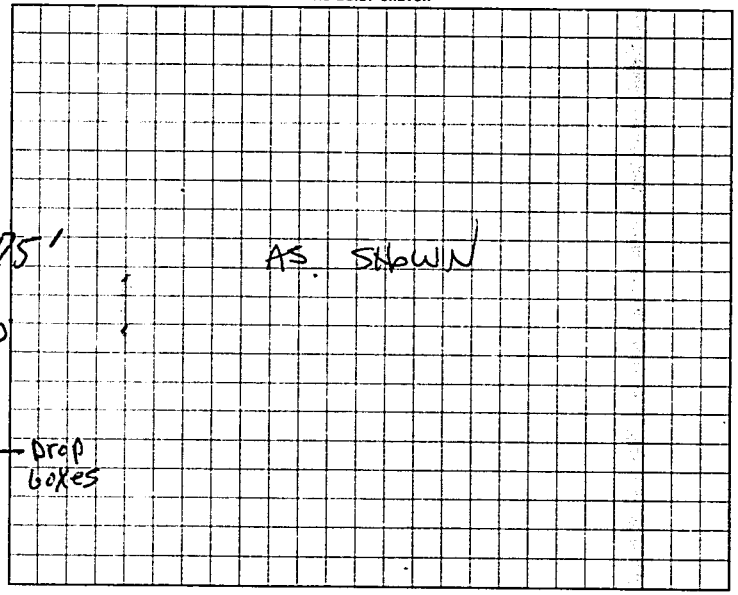

I understand that this permit can be suspended or revoked if any false information is supplied toward securing the permit/any unauthorized changes are made to the site/any unauthorized changes are made in the installation of the system.

Signed: X Scott Bass

Improvement Permit by: L. C. Moore date 3-18-96

Authorization to Connect to Existing System Inspected by: L. C. Moore date 3-18-96

Installed by: JAMES HUCKER

Certificate of Completion by: _____ date _____

Operation Permit by: STEVE HEARICK date 8-6-96

WHITE DEPT COPY — GREEN INSPECTION COPY (FINAL) — YELLOW OWNER COPY (FINAL) — PINK INSPECTION COPY (INITIAL) — GOLD OWNER COPY (INITIAL)

Authorization to Const. Expires 60 mos From issu.

00247