IREDELL COUNTY HEALTH DEPARTMENT

STATESVILLE 704-878-5305 MOORESVILLE 704-664-5281

IMPROVEMENT PERMIT / CERTIFICATE OF COMPLETION / OPERATION PERMIT / EXISTING SYSTEM INSPECTION

PROPERTY DESCRIPTION NO. 22247 DATE _____ TAX MAP NO. _____ Watershed: ☐ Yes ☐ No

OWNER OR CONTRACTOR Alan Scott Bass PHONE: Business _____ Home 872-2411 WILK

ADDRESS _____

LOCATION _____

SUBDIVISION _____ BLOCK / SECTION _____ LOT _____ LOT AREA 1 acre SITE CLASS. P5 DESIGN FLOW 360 L.T.A.R. .3

Septic Tank: 1000 Gallons; STB _____ Date _____

Pump Tank: _____ Gallons; PT _____ Date _____

Pump Make: _____ Model _____ Serial No. _____

Nitrification Field: No Fields 1 Square Feet 1200 Linear Feet 400

No Lines 5 Trench Width 36" Max Trench Bottom Depth 36 Gravel Depth 12"

☑ New System ☐ Repair System Type: I II III IV V VI

System Description: Conv. Gravity Pave

Repair System Description: Pump to _____

Maintenance Agreement Required: ☐ Yes ☑ No

☑ House/Mod. Home No. Bedrooms 3/4

☐ Mobile Home No. Bathrooms 2

☐ Business No. Employees _____

☐ Other _____


☐ Slab ☐ Crawl Space ☑ Basement w/plumbing ☐ Basement wo/plumbing

Water Supply: ☐ Individual ☐ Community ☑ Public


Comments:

Comments: 100' x 175' New Additional Land

INITIAL SITE SKETCH

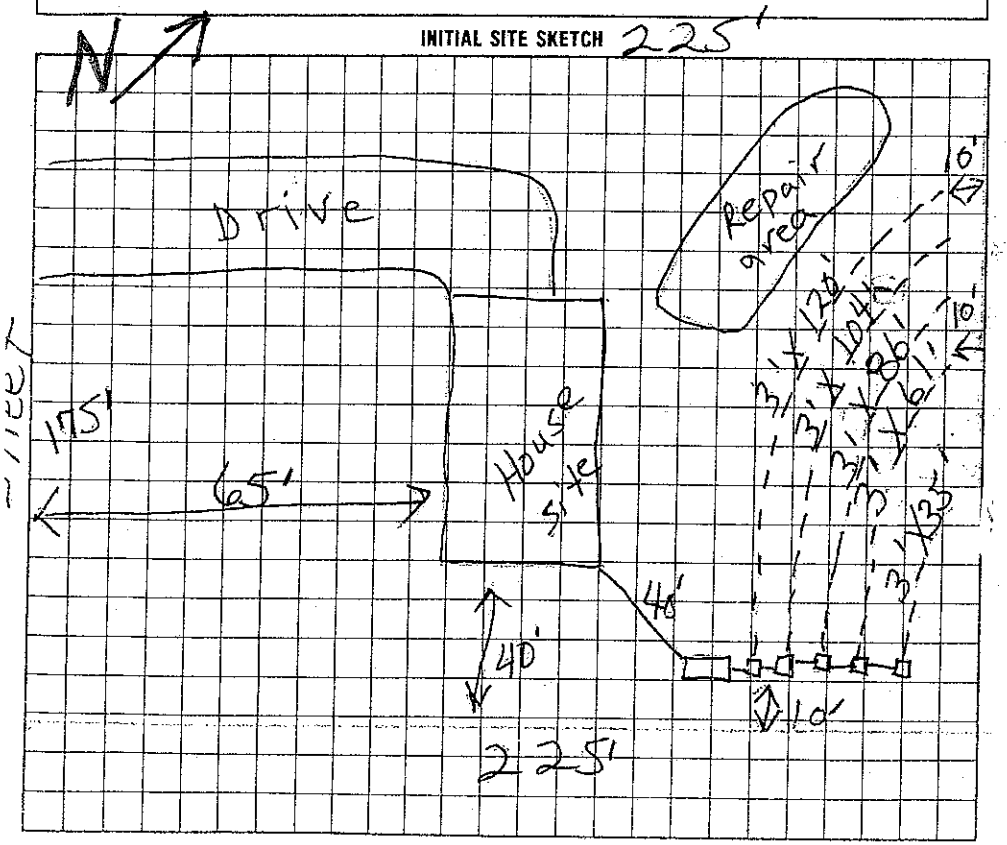

AS BUILT SKETCH

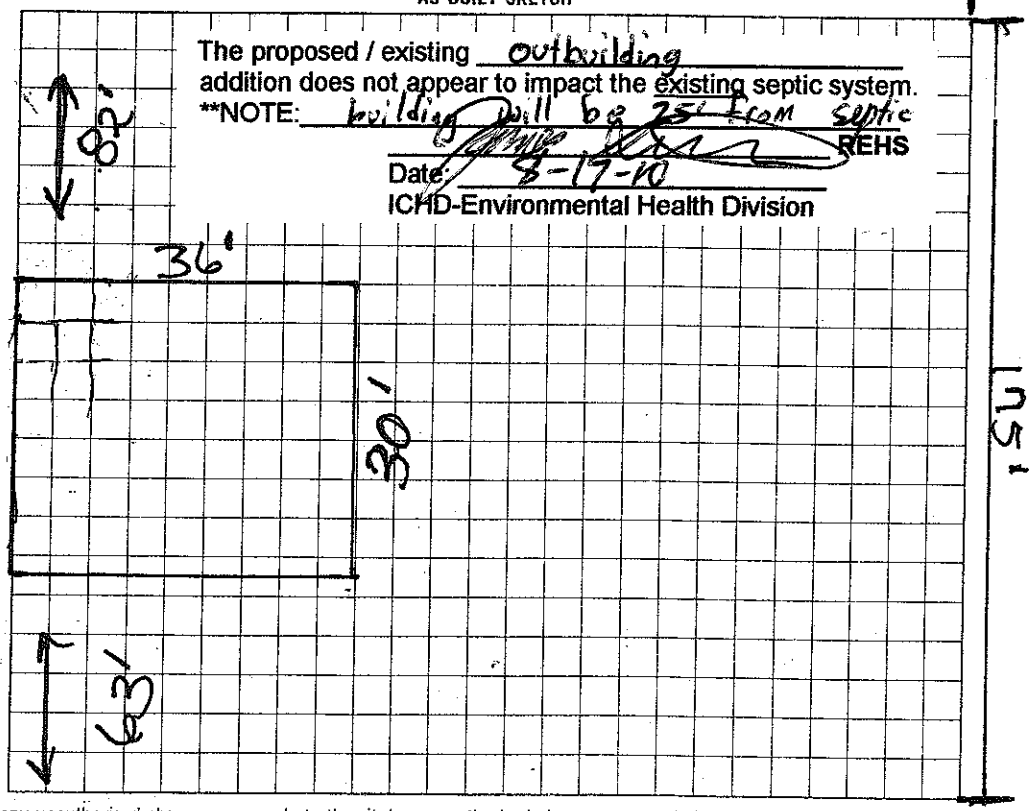

The proposed / existing outbuilding addition does not appear to impact the existing septic system.

**NOTE: building will be 25' from septic

REHS

Date: 5-17-10

ICHD-Environmental Health Division

I understand that this permit can be suspended or revoked if any false information is supplied toward securing the permit/any unauthorized changes are made to the site/any unauthorized changes are made in the installation of the system.

Signed: _____

Improvement Permit by: _____ date _____

Existing System Inspection by: _____ date _____

Installed by: _____

Certificate of Completion by: _____ date 196

Operation Permit by: _____ date _____

HEALTH DEPT. COPY: WHITE INSPECTION COPY (FINAL): GREEN OWNER COPY (FINAL): YELLOW INSPECTION COPY (INITIAL): PINK OWNER COPY (INITIAL): GOLD