IREDELL COUNTY HEALTH DEPARTMENT

STATESVILLE 704-878-5305 MOORESVILLE 704-664-5281

IMPROVEMENT PERMIT / AUTHORIZATION TO CONSTRUCT / OPERATION PERMIT / EXISTING SYSTEM INSPECTION

PERMIT# 79512 PIN# 4712 69 1977 DATE 4-15-99

OWNER OR CONTRACTOR Derrick Bass PHONE: Business _____ Home _____

ADDRESS 253 Black Rd

LOCATION Off Mtn Rd Turn on Celeste Enfield Turn L Black Rd before end TL Behind House 253

SUBDIVISION _____ BLOCK / SECTION _____ LOT _____ LOT AREA 1.167 acres SITE CLASS _____ DESIGN FLOW 360 L.T.A.R. 0.25

Septic Tank: 1000 Gallons; STB 1012 Date 3-3-00
Pump Tank: _____ Gallons; PT _____ Date _____
Pump Make: _____ Model _____ Serial No. _____
Nitrification Field: No Fields 1 Square Feet 1440 Linear Feet 480
No Lines 4 Trench Width 36" Max Trench Bottom Depth 36" Gravel Depth 12"

☑ New System ☐ Repair System Type: I, II, III, IV, V, VI
System Description: Conv. Gravity
Repair System Description: Pump to 25% Rct.
Maintenance Agreement Required: ☐ Yes ☐ No


☐ House/Mod. Home No. Bedrooms 3
☑ Mobile Home No. Bathrooms 2
☐ Business No. Employees ____
☐ Other _____
☐ Slab ☑ Crawl Space ☐ Basement w/plumbing ☐ Basement wo/plumbing

Water Supply: ☐ Individual ☑ Public ☐ Community


Comments/Conditions:
600'+

Comments/Conditions

INITIAL SITE SKETCH

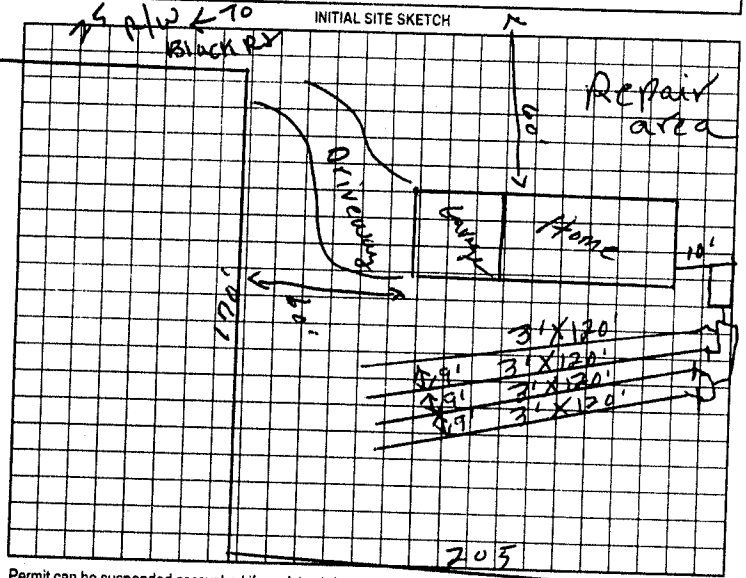

AS BUILT SKETCH

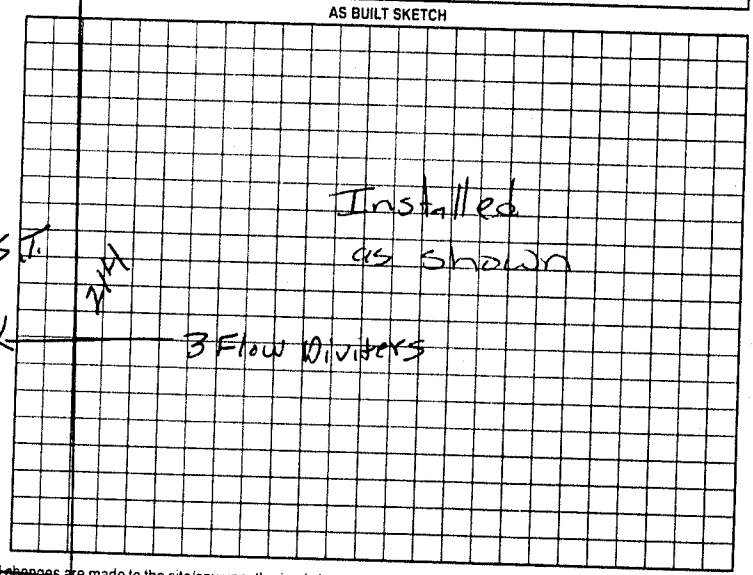

Permit can be suspended or revoked if any false information is supplied toward securing the permit/any unauthorized changes are made to the site/any unauthorized changes are made in the installation of the system. Improvement Permit with plat valid without expiration. Improvement Permit with site plan valid for sixty months. Authorization to Construct is valid for a period equal to that of Improvement Permit – not to exceed sixty months.

Signed: X Derrick Bass date 4-15-99 Installed by: Brent Gallberg

Improvement Permit by: R.C. Moore date 4-15-99 Operation Permit by: Matt Coffey RS date 5-9-00

Authorization to Construct by: R.C. Moore date 4-15-99 Existing System Inspection by: _____ date _____

HEALTH DEPT. COPY: WHITE OWNER COPY (FINAL) YELLOW OWNER COPY (INITIAL) PINK