This Permit voids previously issued Permit 10/25/00

IREDELL COUNTY HEALTH DEPARTMENT

STATESVILLE 704-878-5305 / MOORESVILLE 704-664-5281

IMPROVEMENT PERMIT / AUTHORIZATION TO CONSTRUCT / OPERATION PERMIT / EXISTING SYSTEM INSPECTION

PERMIT# 089330 PIN# 4713632148 (pt) DATE 2/4/02

OWNER OR CONTRACTOR Premier Developers / Earl Carrick PHONE: Business (704) 892-7788 Home —

ADDRESS 485 S Sam Furr Rd Huntersville, N.C. 28078

LOCATION From Troutman - O/L Mt. Ex. Smiths on Left past Buffalo Shoal Road

SUBDIVISION Angel Oaks BLOCK / SECTION — LOT 39 LOT AREA 1.54 SITE CLASS PS DESIGN FLOW 480 L.T.A.R. .25

Septic Tank: 1000 Gallons: STB 1007 Date 1-17-02
Pump Tank: 1000 Gallons: PT 274 Date 1-3-02
Pump Make: Hydromatic Model SAEF50A1 Serial No —
Nitrification Field: No Fields 1 Square Feet 1920 Linear Feet 480
No Lines 4 @ 120 Trench Width 36" Max Trench Bottom Depth 30"

[X] New System [ ] Repair System Type: I, II, III, IV, V, VI
System Description: PM - Innovative - 25% Red
Repair System Description: LPP 50% Red
Maintenance Agreement Required: [ ] Yes [X] No
Gravel Depth N/A [ ] Slab [X] Crawl Space [ ] Basement w/plumbing [ ] Basement wo/plumbing

[X] House/Mod. Home No. Bedrooms 4
[ ] Mobile Home No. Bathrooms 3
[ ] Business No. Employees —
[ ] Other —


Water Supply: [ ] Individual [X] Public [ ] Community

Comments/Conditions: Lot 41


Lot 40

Comments/Conditions: Poly-lok Filter, ST. marker Installed 2/26/02-WJ
-76 Bio-Diffuser Chamber Installed 2/26/02-WJ
-Pressure Check Okay - 2/26/02-WJ
-Electrical + Alarm checked Okay 5/15/02-WJ

INITIAL SITE SKETCH

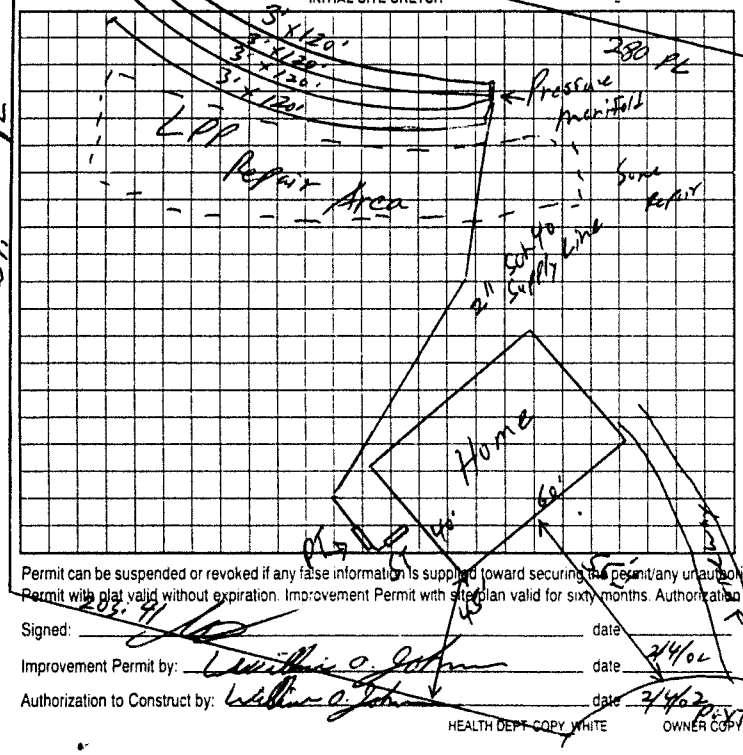

AS BUILT SKETCH

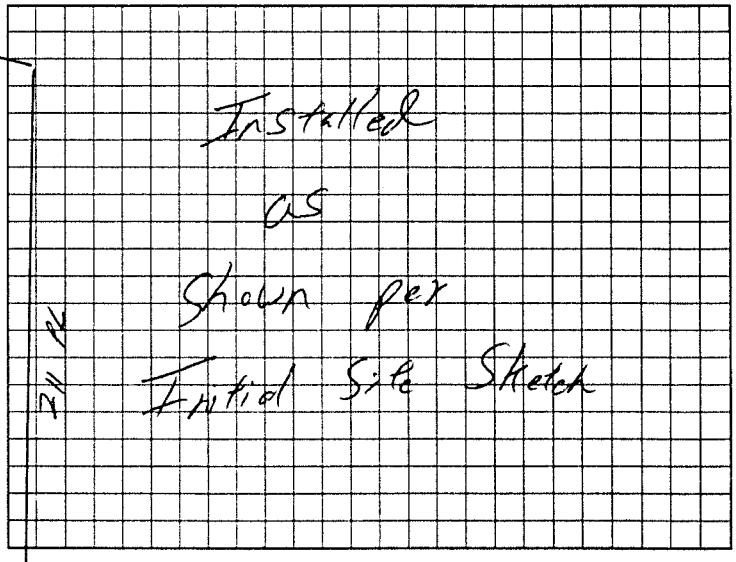

Permit can be suspended or revoked if any false information is supplied toward securing the permit/any unauthorized changes are made to the site/any unauthorized changes are made in the installation of the system. Improvement Permit with plat valid without expiration. Improvement Permit with site plan valid for sixty months. Authorization to Construct is valid for a period equal to that of Improvement Permit – not to exceed sixty months.

Signed: — date — Installed by: Sonny Shoemaker

Improvement Permit by: William O. Johnson date 2/4/02 Operation Permit by: William O. Johnson date May 15, 2002

Authorization to Construct by: William O. Johnson date 2/4/02 Existing System Inspection by: — date —

HEALTH DEPT COPY (WHITE) OWNER COPY (FINAL) (YELLOW) OWNER COPY (INITIAL) (PINK)