This Permit voids previously issued permit 10/25/00

IREDELL COUNTY HEALTH DEPARTMENT

STATESVILLE 704-878-5305 / MOORESVILLE 704-664-5281

IMPROVEMENT PERMIT / AUTHORIZATION TO CONSTRUCT / OPERATION PERMIT / EXISTING SYSTEM INSPECTION

PERMIT# OB9330 PIN# 4913632148 (pt) DATE 3/4/02

OWNER OR CONTRACTOR Premier Pavestone / Pearl Concrete PHONE. Business (704) 892-7788 Home —

ADDRESS 485 S Sam Furr Rd Huntersville N.C 28078

LOCATION From Torrence – Rt on Rt. Swinks on Left past Buffalo Shoals Road

SUBDIVISION Angel Oaks BLOCK / SECTION — LOT 32 LOT AREA 1.54 SITE CLASS. PS DESIGN FLOW 480 L.T.A.R .25

Septic Tank: 1000 Gallons. STB 1007 Date 1-17-02
Pump Tank: 1000 Gallons. PT 294 Date 1-3-02
Pump Make: Hydromatic Model SAE-50AL Serial No —
Nitrification Field: No Fields 1 Square Feet 1920 Linear Feet 480
No Lines 40 Trench Width 36" Max Trench Bottom Depth 30" Gravel Depth N/A

☒ New System ☐ Repair System Type: I, II, III, IV, V, VI
System Description: PM – Innovative – 258 LPP 56% Red
Repair System Description: LPP
Maintenance Agreement Required: ☐ Yes ☒ No


☒ House/Mod. Home ☐ Mobile Home ☐ Business ☐ Other
No. Bedrooms 4 No. Bathrooms 3 No. Employees —

Water Supply: ☐ Individual ☒ Public ☐ Community

☐ Slab ☒ Crawl Space ☐ Basement w/plumbing ☐ Basement wo/plumbing


Comments/Conditions: Lot 4

INITIAL SITE SKETCH

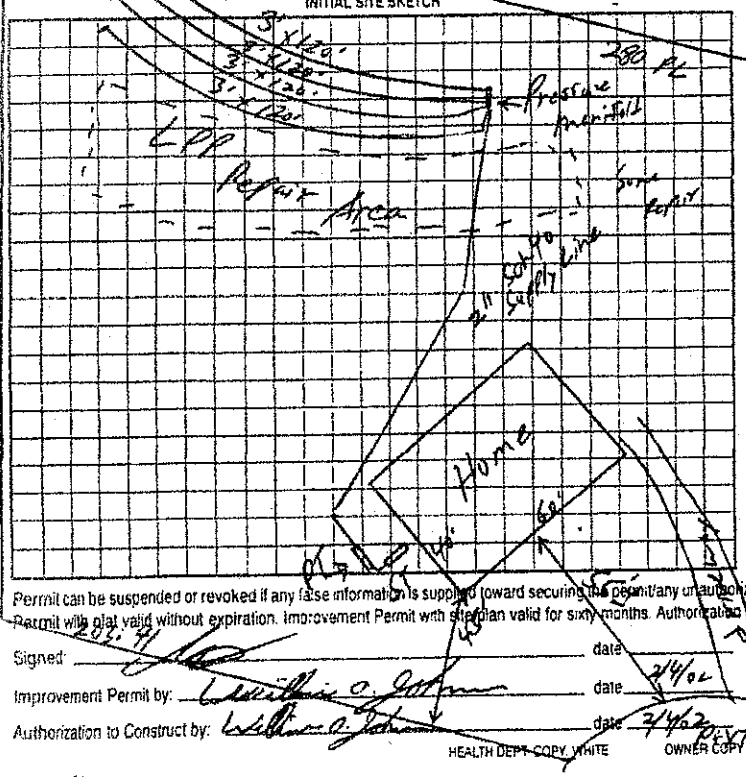

Comments/Conditions: Polylok Filter, ST. marker Installed 2/26/02-LWS
-76 Bio-Enhancer Chamber Installed 2/26/02-LWS
-Pressure Check okay - 2/26/02-LWS
-Electrical & Alarm Checked Okay 5/1/02-GH

AS BUILT SKETCH

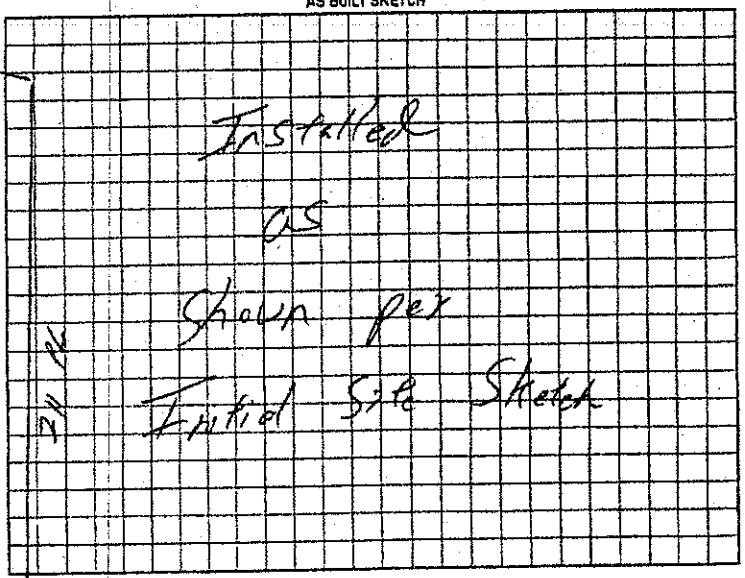

Permit can be suspended or revoked if any false information is supplied toward securing the permit/any unauthorized changes are made to the site/any unauthorized changes are made in the installation of the system. Improvement Permit will not valid without expiration. Improvement Permit with site plan valid for sixty months. Authorization to Construct is valid for a period equal to that of Improvement Permit – not to exceed sixty months.

Signed: [signature] date —

Improvement Permit by: [signature] date 2/4/02

Authorization to Construct by: [signature] date 3/4/02

Installed by: Sonny Shoemaker

Operation Permit by: [signature] date May 15, 2002

Existing System Inspection by: — date —

HEALTH DEPT COPY WHITE OWNER COPY (FINAL) YELLOW OWNER COPY (INITIAL) PINK

Location of the proposed 16'x34' Deck addition does not appear to impact the existing on-site septic system.**NOTE:

[signature] REHS

Date: 4-30-12

ICHD-Environmental Health Division