IREDELL COUNTY HEALTH DEPARTMENT

STATESVILLE 704-878-5305 MOORESVILLE 704-664-5281

CT

IMPROVEMENT PERMIT / AUTHORIZATION TO CONSTRUCT / OPERATION PERMIT / EXISTING SYSTEM INSPECTION

PERMIT# 137148 PIN# ~~4713540966~~ 4713543836 DATE 8-22-06

OWNER OR APPLICANT Roy Hoke PHONE: Business 704-585-9874 Home

ADDRESS 362 Rotech Road Stony Point NC 28678

LOCATION Old Mtn Rd past Celeste Henkel Elem. on left after Brick house

SUBDIVISION BLOCK / SECTION LOT 1 LOT AREA .56 SITE CLASS. PS DESIGN FLOW 360 L.T.A.R. .25

Septic Tank: 1000 Gallons; STB 100 Date 3-17-06
Pump Tank: Gallons; PT Date
Pump Make: Model Serial No.
Nitrification Field: No Fields Square Feet 1440 Linear Feet 360
No Lines 4 Trench Width 36" Max Trench Bottom Depth 30" Gravel Depth

☑ New System ☐ Repair ☐ Expansion System Type: I II III IV V VI
System Description: 25% Gravel
Repair System Description: Low Pres Pan
Maintenance Agreement Required: ☐ Yes ☐ No
☑ Gravity ☐ Pressure ☐ Slab ☑ Crawl Space ☐ Basement w/plumbing ☐ Basement wo/plumbing


☑ House/Mod. Home ☒ Mobile Home ☐ Business ☐ Other
No. Bedrooms 3 No. Persons No. Employees

Water Supply: ☑ Individual ☐ Public ☐ Community


Comments:/Conditions:

Comments:/Conditions:
Install on contour
Maintain all setbacks
Jellco Inf-Tile
Septic tank marker

INITIAL SITE SKETCH

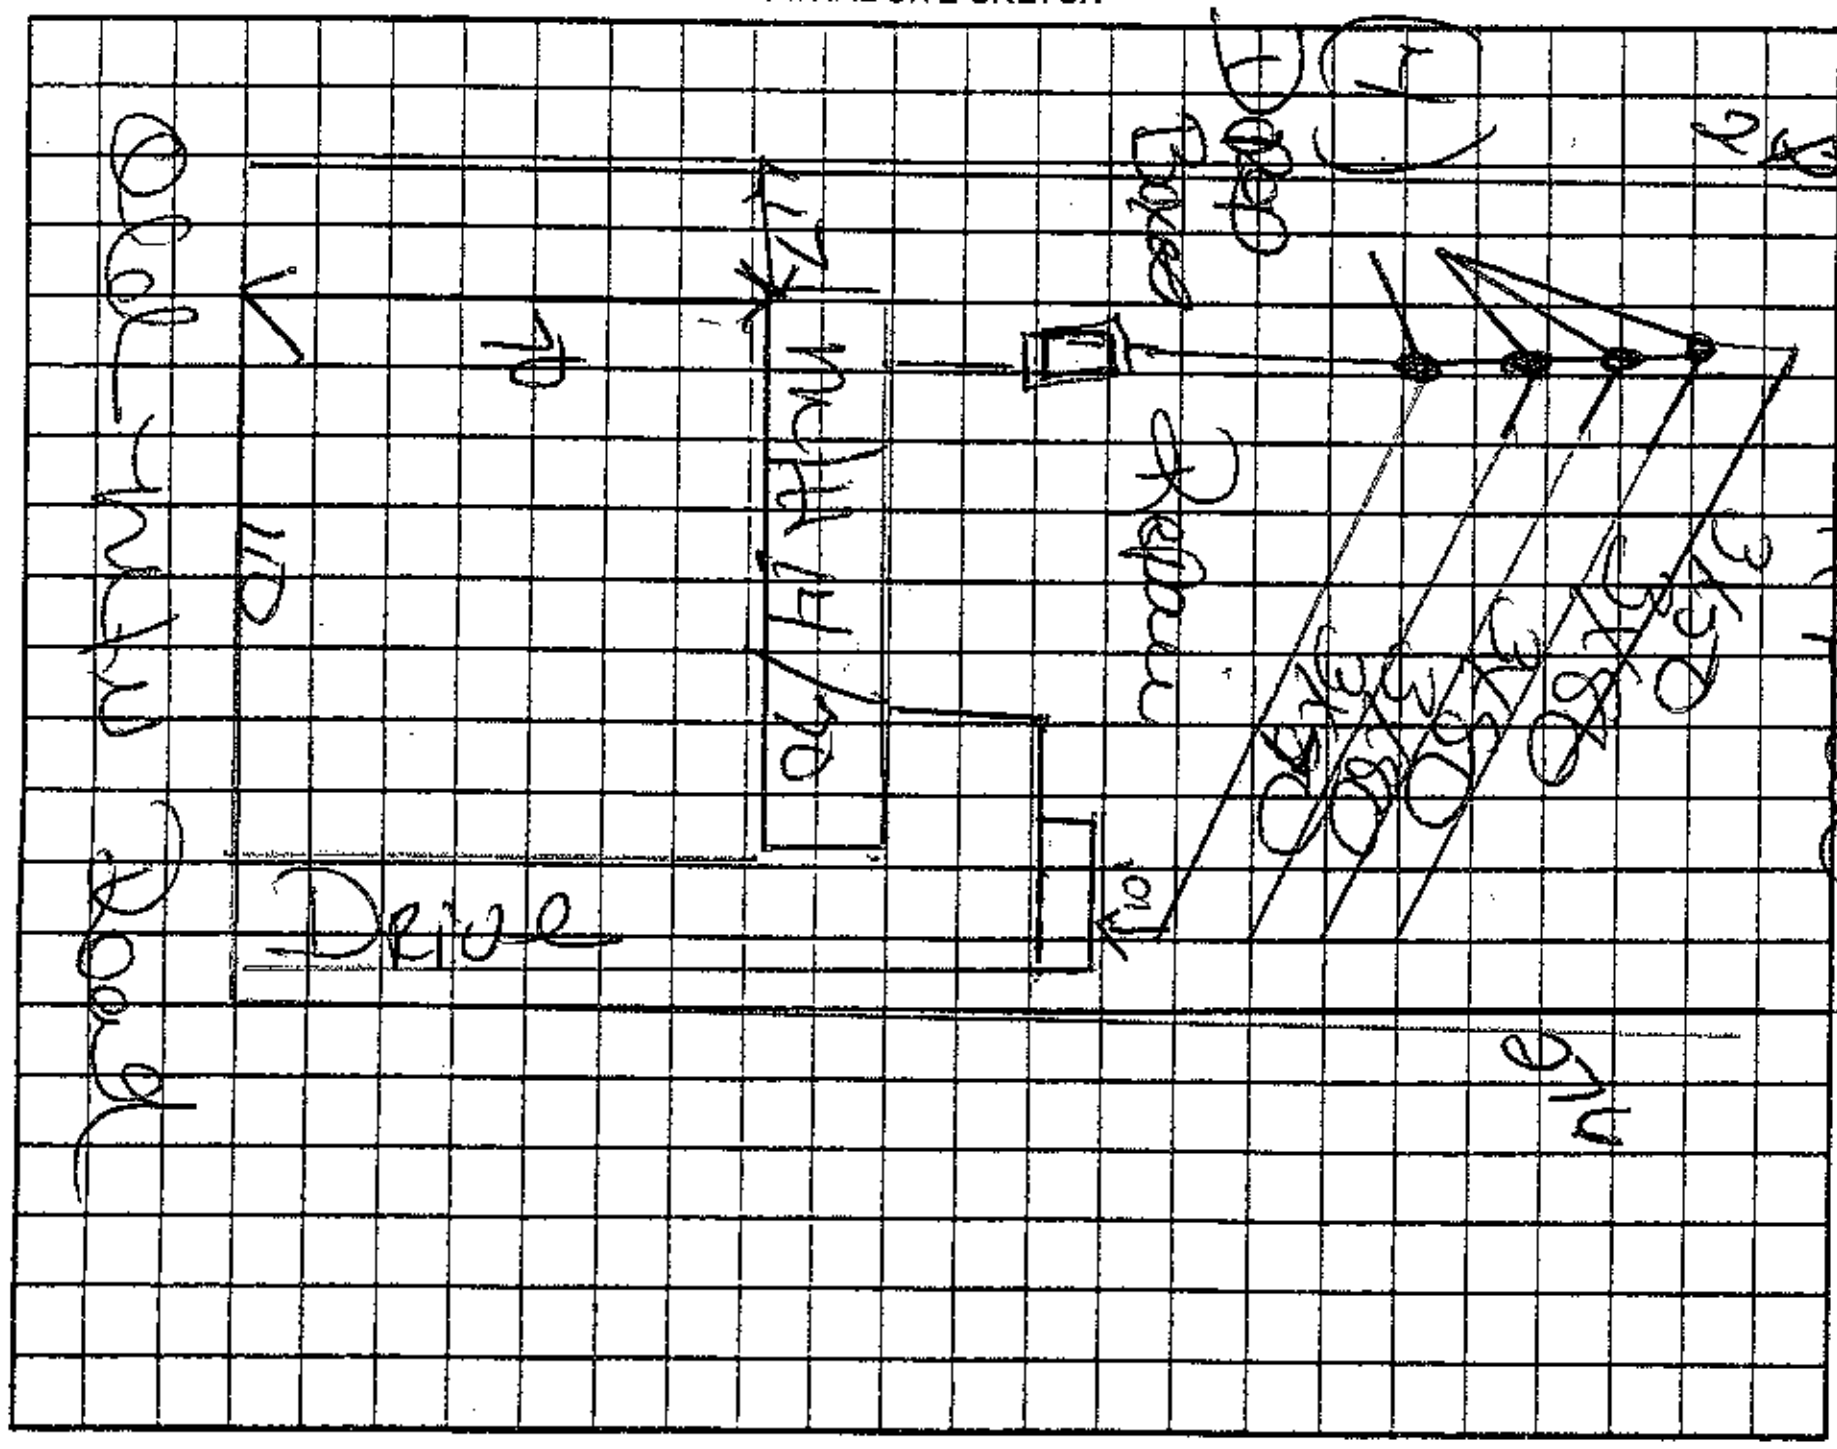

AS BUILT SKETCH

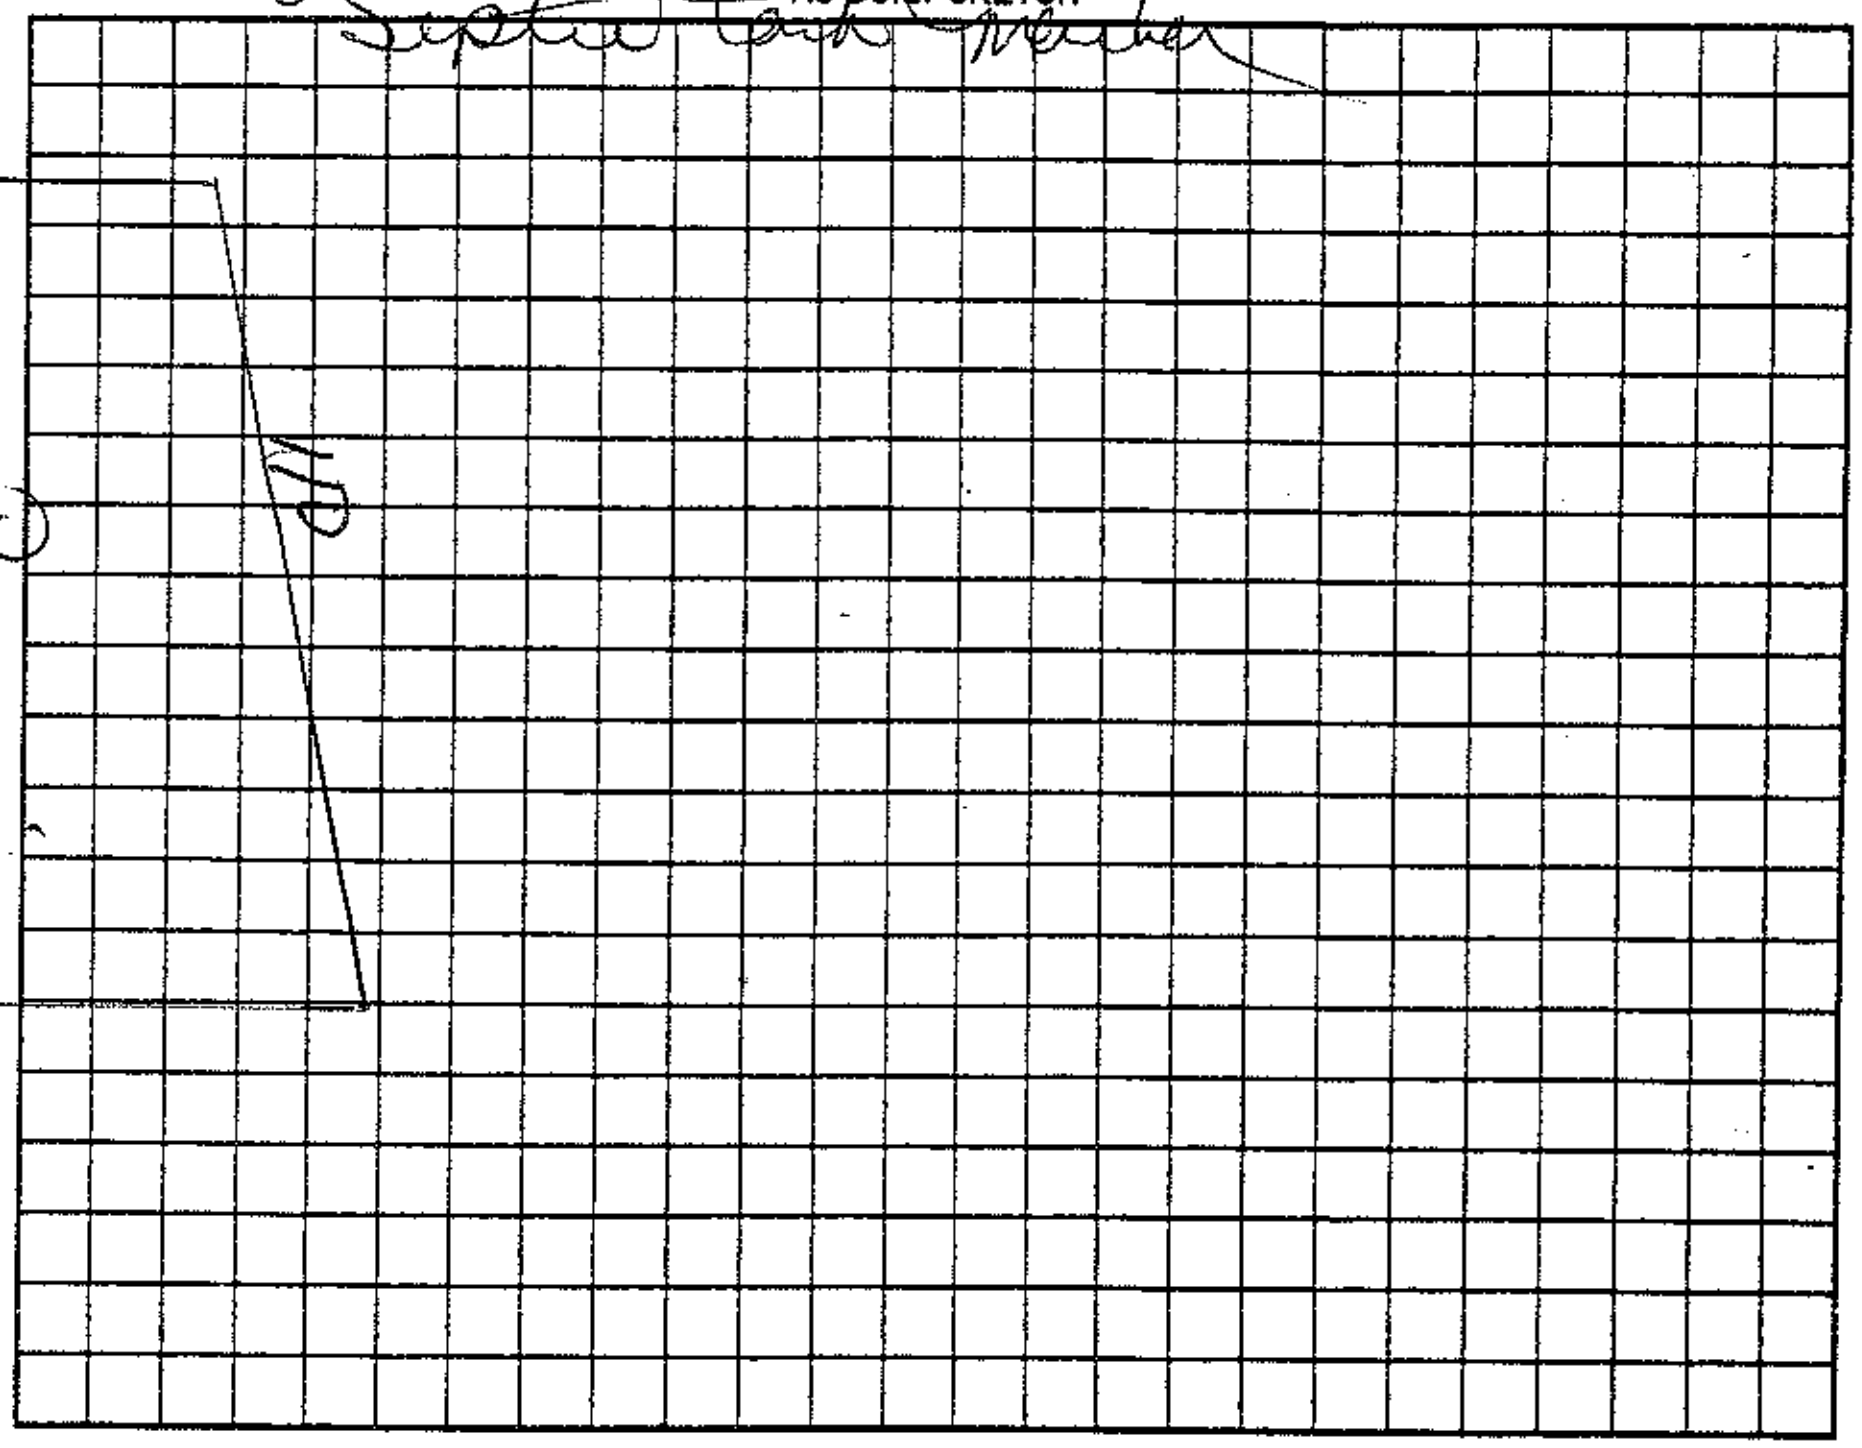

Permit can be suspended or revoked if any false information is supplied toward securing the permit/any unauthorized changes are made to the site/any unauthorized changes are made in the installation of the system. Improvement Permit with plat valid without expiration ☐ Improvement Permit with site plan valid for sixty months ☐ Authorization to Construct is valid for a period equal to that of Improvement Permit – not to exceed sixty months.

Signed: Roy Hoke date

Improvement Permit by: Kelly Cook date 8-22-06

Authorization to Construct by: Kelly Cook date 8-22-06

Installed by: Wingler Loader Work

Operation Permit by: Kelly J Cook date 9-12-06

Existing System Inspection by: date

HEALTH DEPT. COPY: WHITE OWNER COPY (FINAL): YELLOW OWNER COPY (INITIAL): PINK