IREDELL COUNTY HEALTH DEPARTMENT Const. Hsg. STATESVILLE 704-878-5305 MOORESVILLE 704-664-5281

IMPROVEMENT PERMIT / ~~CERTIFICATE OF COMPLETION~~ / OPERATION PERMIT / EXISTING SYSTEM INSPECTION

PROPERTY DESCRIPTION NO. 067097 DATE June 11, '97 TAX MAP NO. 4713563365 Watershed: ☐ Yes ☑ No

OWNER OR CONTRACTOR Deborah L. Barnes PHONE: Business _____ Home _____

ADDRESS 614 Alexander St. Statesville

LOCATION Old Mtn. Rd. Turn across from Cibik Hackle Sch onto Bethlehem Rd TL Doubletree on Rt. @ jct w/ Sonoa

SUBDIVISION Mtn Rd. Village BLOCK / SECTION _____ LOT 41 LOT AREA 20,000 ft² + SITE CLASS. PS DESIGN FLOW 360 gpd L.T.A.R. 1.03

Septic Tank: 1000 Gallons; STB 1012 Date 5-8-97

Pump Tank: _____ Gallons; PT _____ Date _____

Pump Make: _____ Model _____ Serial No. _____

Nitrification Field: No Fields 1 Square Feet 1200 Linear Feet 400

No Lines 5 @ 80' Trench Width 36" Max Trench Bottom Depth 16-24" Gravel Depth 12"

☐ New System ☐ Repair System Type: I, II, III, IV, V, VI

System Description: gravity conventional

Repair System Description: Grass panel Chambered

Maintenance Agreement Required: ☐ Yes ☑ No

☐ House/Mod. Home ☑ Mobile Home ☐ Business ☐ Other

No. Bedrooms 3 No. Bathrooms 2 No. Employees _____


☐ Slab ☑ Crawl Space ☐ Basement w/plumbing ☐ Basement wo/plumbing

Water Supply: ☐ Individual ☐ Community ☑ Public


Comments: Septic installer note trench bottom depth +

Comments:

INITIAL SITE SKETCH 1" = 50'

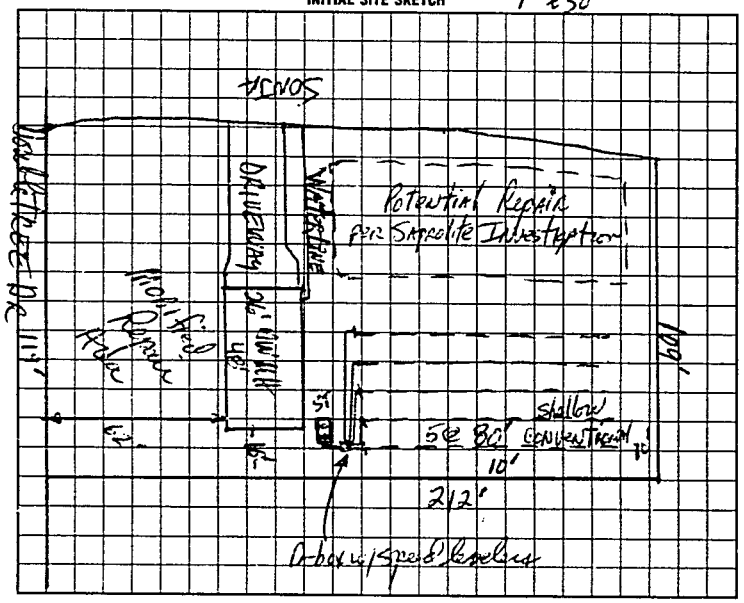

AS BUILT SKETCH

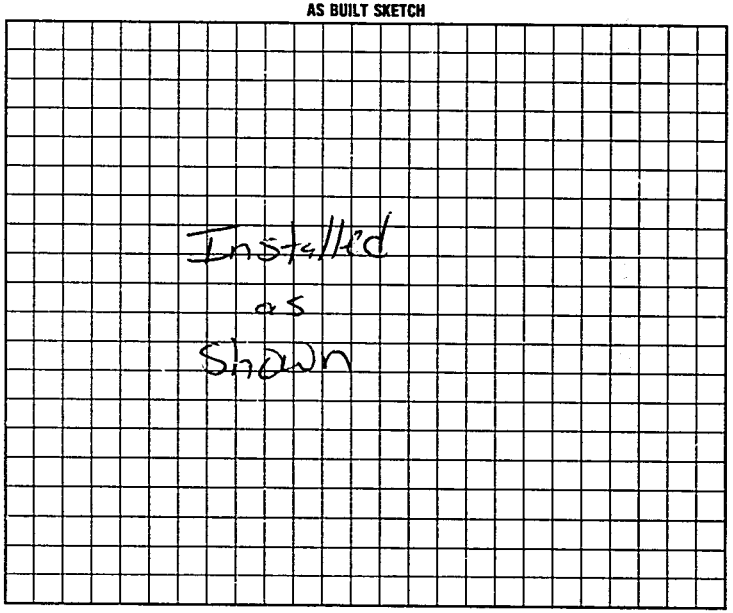

I understand that this permit can be suspended or revoked if any false information is supplied toward securing the permit/any unauthorized changes are made to the site/any unauthorized changes are made in the installation of the system. Improvement Permit is valid for 60 months from date of issuance.

Signed: Leon Gray

Improvement Permit by: D K Hinson, RS date 6-11-97

~~Construction~~ Authorization by: D K Hinson, RS date 6-11-97

Installed by: Dale Fox

Certificate of Completion by: _____ date _____

Operation Permit by: Mark C. Ort RS date 6-30-97

HEALTH DEPT COPY: WHITE INSPECTION COPY (FINAL): GREEN OWNER COPY (FINAL): YELLOW INSPECTION COPY (INITIAL): PINK OWNER COPY (INITIAL): GOLD

9700300