67582

IREDELL COUNTY HEALTH DEPARTMENT

STATESVILLE 704-878-5305 MOORESVILLE 704-664-5281

IMPROVEMENT PERMIT / CERTIFICATE OF COMPLETION / OPERATION PERMIT / EXISTING SYSTEM INSPECTION

PROPERTY DESCRIPTION NO. 25682 DATE 12-16-96 TAX MAP NO. 8K-8- A-37 Watershed: ☐ Yes ☐ No WS IV-CA

OWNER OR CONTRACTOR Paul Murphy PHONE: Business Home 546 5208

ADDRESS 503 Cranesill Rd Harmony N.C. 28634

LOCATION 012 mtn Rd Turn Bethlehem Rd TL Double Tree 1/5mi Rt

SUBDIVISION Mt. Roadville BLOCK / SECTION LOT 37 LOT AREA 23,400 SF SITE CLASS. PS DESIGN FLOW 360 L.T.A.R. 13

Septic Tank: 1000 Gallons; STB 1012 Date 12-1-96

Pump Tank: Gallons; PT Date

Pump Make: Model Serial No.

Nitrification Field: No Fields 1 Square Feet 900 Linear Feet 300

No Lines 7 Trench Width 36" Max Trench Bottom Depth 36" Gravel Depth N/A

☑ New System ☐ Repair System Type: I, II, III, IV, V, VI

System Description: Gravity Chambers

Repair System Description: " Panels

Maintenance Agreement Required: ☐ Yes ☑ No

☐ House/Mod. Home ☑ Mobile Home ☐ Business ☐ Other

No. Bedrooms 3 No. Bathrooms 2 No. Employees


☐ Slab ☐ Crawl Space ☐ Basement w/plumbing ☐ Basement wo/plumbing

Water Supply: ☐ Individual ☐ Community ☑ Public


Comments:

Comments:

INITIAL SITE SKETCH

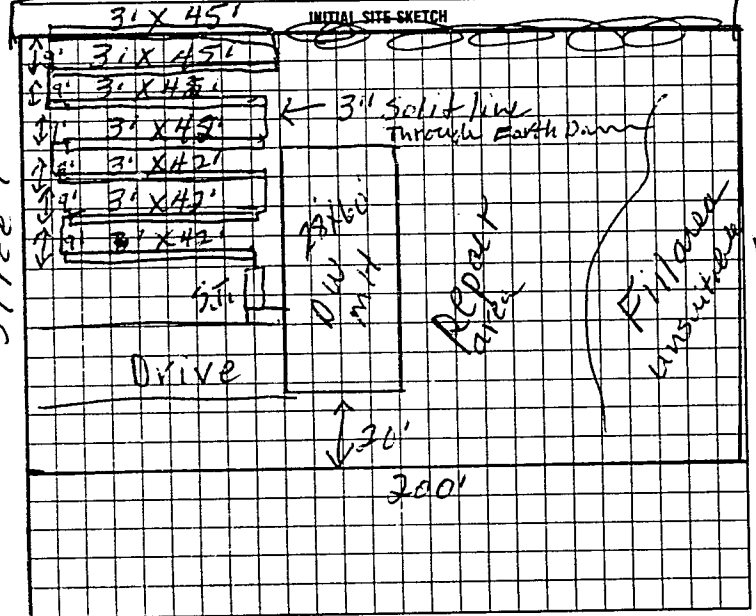

AS BUILT SKETCH

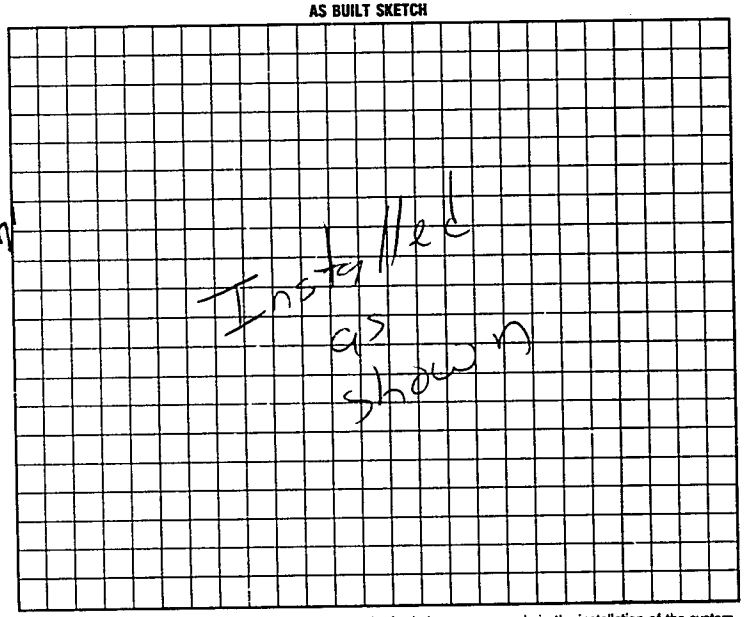

I understand that this permit can be suspended or revoked if any false information is supplied toward securing the permit/any unauthorized changes are made to the site/any unauthorized changes are made in the installation of the system. Improvement Permit is valid for 60 months from date of issuance

Signed: Paul Murphy

Installed by: A-1 Backhoe

Improvement Permit by: P.C. Moore date 12-16-96

Certificate of Completion by: date

Existing System Inspected by: P.C. Moore date 12-16-96 Operation Permit by: date 1-21-97

to Count. authorization to count Expires 6 months from issue

HEALTH DEPT. COPY: WHITE INSPECTION COPY (FINAL): GREEN OWNER COPY (FINAL): YELLOW INSPECTION COPY (INITIAL): PINK OWNER COPY (INITIAL): GOLD

IE9100