IREDELL COUNTY HEALTH DEPARTMENT

STATESVILLE 704-878-5305 MOORESVILLE 704-664-5281

IMPROVEMENT PERMIT / CERTIFICATE OF COMPLETION / OPERATION PERMIT / EXISTING SYSTEM INSPECTION

PROPERTY DESCRIPTION NO. 26099 DATE 2-6-97 TAX MAP NO. 4713566331 Watershed: ☐ Yes ☒ No

OWNER OR CONTRACTOR Harry L. Gooden PHONE: Business _____ Home 878-0717

ADDRESS 120 Kimberly Ln Statesville 28678

LOCATION I-40 To Old Mtn Rd To Bethlehem To Double Tree TR Sonja 2nd lot on Rt

SUBDIVISION Mineral Village BLOCK / SECTION _____ LOT 44 LOT AREA 200x110 SITE CLASS. P/S DESIGN FLOW 480 L.T.A.R. 0.3

Septic Tank: 1000 Gallons; STB 1012 Date 1-17-97

Pump Tank: _____ Gallons; PT _____ Date _____

Pump Make: _____ Model _____ Serial No. _____

Nitrification Field: No Fields 1 Square Feet 840 Linear Feet 280

No Lines 4 Trench Width 34in Max Trench Bottom Depth 36in Gravel Depth _____

☒ New System ☐ Repair System Type: I, II, III, IV, V, VI

System Description: Gravity Pump

Repair System Description: Gravity Pump

Maintenance Agreement Required: ☐ Yes ☒ No

☐ Slab ☒ Crawl Space ☐ Basement w/plumbing ☐ Basement wo/plumbing

☐ House/Mod. Home ☒ Mobile Home ☐ Business ☐ Other


No. Bedrooms 4 No. Bathrooms 2 No. Employees _____

Water Supply: ☐ Individual ☐ Community ☒ Public


Comments: Keep lines on Contour 8ft on center 16 panels per line 4 lines total

Comments:

INITIAL SITE SKETCH

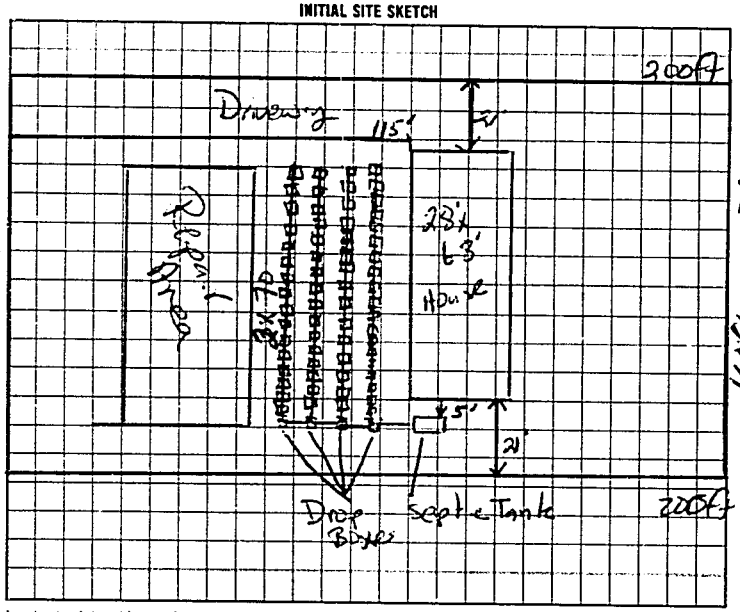

AS BUILT SKETCH

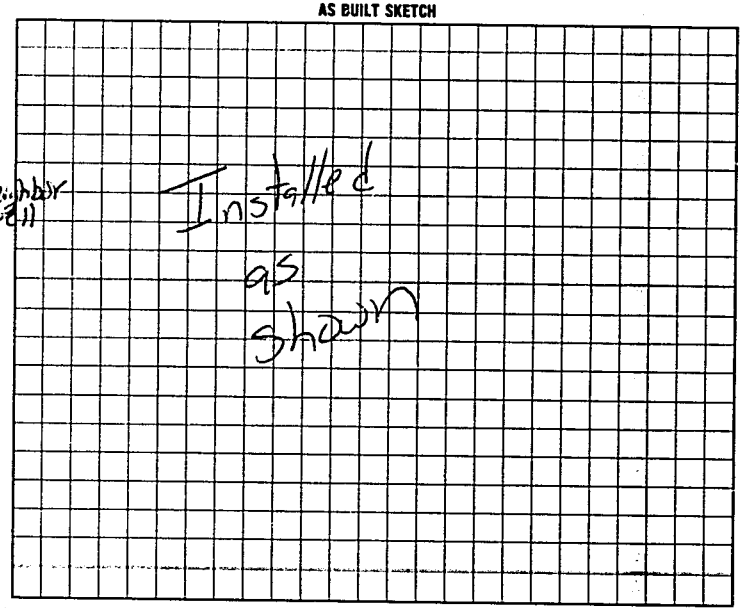

I understand that this permit can be suspended or revoked if any false information is supplied toward securing the permit/any unauthorized changes are made to the site/any unauthorized changes are made in the installation of the system. Improvement Permit is valid for 60 months from date of issuance. Authorization to construct expires 5yrs from issue date

Signed: Harry L. Gooden

Improvement Permit by: Mark Craft RS date 2-6-97

Authorization to Const. Existing system inspection by: Mark Craft RS date 2-6-97

Installed by: Kenny Madison

Certificate of Completion by: _____ date _____

Operation Permit by Mark Craft RS date 4-4-97

HEALTH DEPT. COPY: WHITE INSPECTION COPY (FINAL): GREEN OWNER COPY (FINAL): YELLOW INSPECTION COPY (INITIAL): PINK OWNER COPY (INITIAL): GOLD