62887

IREDELL COUNTY HEALTH DEPARTMENT

STATESVILLE 704-878-5305 MOORESVILLE 704-664-5281

IMPROVEMENT PERMIT / CERTIFICATE OF COMPLETION / OPERATION PERMIT / EXISTING SYSTEM INSPECTION

PROPERTY DESCRIPTION NO. 24011 DATE 7-23-96 TAX MAP NO. 8K-12-A-7 Watershed: ☐ Yes ☒ No

OWNER OR CONTRACTOR Reed Strouf PHONE: Business 876-6017 Home

ADDRESS 162 Rigby Lane Hiddenite

LOCATION Off Hwy 90 Rt Turn on Bethlehem Ch Rd TL Happy Lane at end

SUBDIVISION Gartenpk. BLOCK / SECTION LOT 7 LOT AREA 4.5 acres SITE CLASS. PS DESIGN FLOW 360 L.T.A.R. .3

Septic Tank: 1000 Gallons; STB 1012 Date 9-2-96

Pump Tank: Gallons; PT Date

Pump Make: Model Serial No.

Nitrification Field: No Fields 1 Square Feet 1200 Linear Feet 400

No Lines 4 Trench Width 36" Max Trench Bottom Depth 36" Gravel Depth 12"

☒ New System ☐ Repair System Type: I, II, III, IV, V, VI

System Description: Conv. Gravity

Repair System Description: " "

Maintenance Agreement Required: ☐ Yes ☒ No

☐ House/Mod. Home ☒ Mobile Home ☐ Business ☐ Other

No. Bedrooms 3 No. Bathrooms 2 No. Employees


☐ Slab ☒ Crawl Space ☐ Basement w/plumbing ☐ Basement wo/plumbing

Water Supply: ☒ Individual ☐ Community ☐ Public


Comments:

Comments:

INITIAL SITE SKETCH

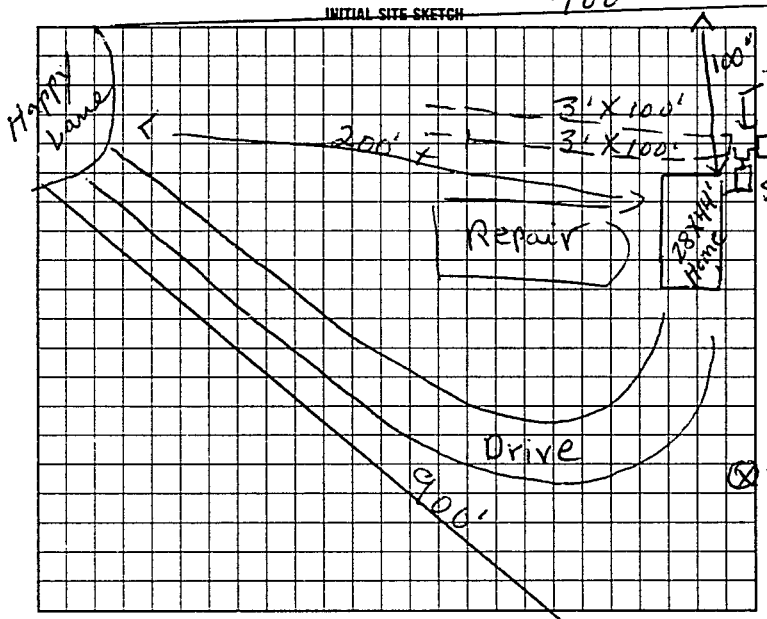

AS BUILT SKETCH

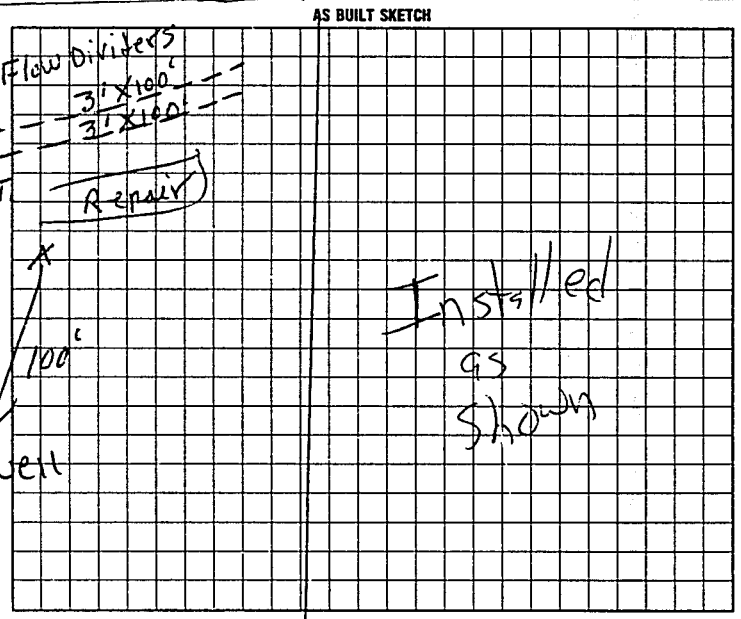

I understand that this permit can be suspended or revoked if any false information is supplied toward securing the permit/any unauthorized changes are made to the site/any unauthorized changes are made in the installation of the system.

Signed: X Reed Strouf Installed by: Esker Elder

Improvement Permit by: P.C. Moore date 7-23-96 Certificate of Completion by: date

Existing System Inspection by: P.C. Moore date 7-23-96 Operation Permit by: Mark C Orf date 12-9-96

Authorization to Const

HEALTH DEPT. COPY: WHITE INSPECTION COPY (FINAL): GREEN OWNER COPY (FINAL): YELLOW INSPECTION COPY (INITIAL): PINK OWNER COPY (INITIAL): GOLD

Authorization to Const Expires 6 mos from issue

8 5 2 2 0 0