IREDELL COUNTY HEALTH DEPARTMENT

STATESVILLE 704-878-5305 MOORESVILLE 704-664-5281

IMPROVEMENT PERMIT / AUTHORIZATION TO CONSTRUCT / OPERATION PERMIT / EXISTING SYSTEM INSPECTION

PERMIT# 10105120 PIN# 4713 56 8942 B DATE 7/17/01

OWNER OR CONTRACTOR Sabrina Strand PHONE: Business — Home (704) 871-9950

ADDRESS 169 Happy Lane Statesville N.C. 28677

LOCATION I-40 W, @ Stamey Farm Rd, Straight across Hwy 70 to Bethlehem Rd, @ on Happy Lane on Left @ End of Road.

SUBDIVISION — BLOCK / SECTION — LOT — LOT AREA — SITE CLASS. PS DESIGN FLOW 360 L.T.A.R. .3

Septic Tank: 4000 Gallons; STB 760 Date 5-1-01
Pump Tank: — Gallons; PT — Date —
Pump Make: — Model — Serial No —
Nitrification Field: No Fields 1 Square Feet 1200 Linear Feet 300
No Lines 3 Trench Width 36" Max Trench Bottom Depth 36" Gravel Depth —

[X] New System [ ] Repair System Type: I, II, III, IV, V, VI
System Description: Gravity, 25% Reduction
Repair System Description: Pump 50% Reduction
Maintenance Agreement Required: [ ] Yes [X] No

[ ] House/Mod. Home No. Bedrooms 3
[X] Mobile Home No. Bathrooms 2
[ ] Business No. Employees —
[ ] Other —


[ ] Slab [X] Crawl Space [ ] Basement w/plumbing [ ] Basement wo/plumbing

Water Supply: [X] Individual [ ] Public [ ] Community


Comments/Conditions: ① Install lines on contour ② Install 25% Reduction System 30-10" HDES Sections or 50 Chambers

Comments/Conditions:
- Installed 50 Bio Diffuser Chambers
- Label filter Installed

INITIAL SITE SKETCH 205' PL Not to Scale

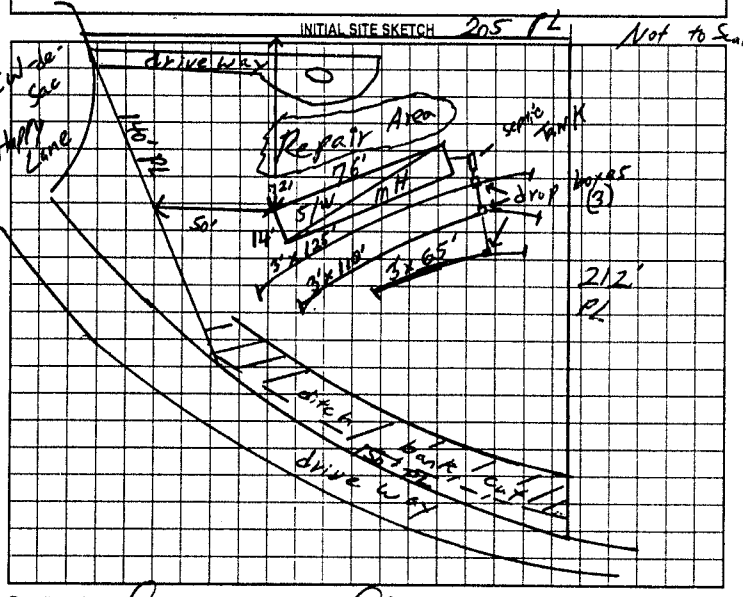

AS BUILT SKETCH

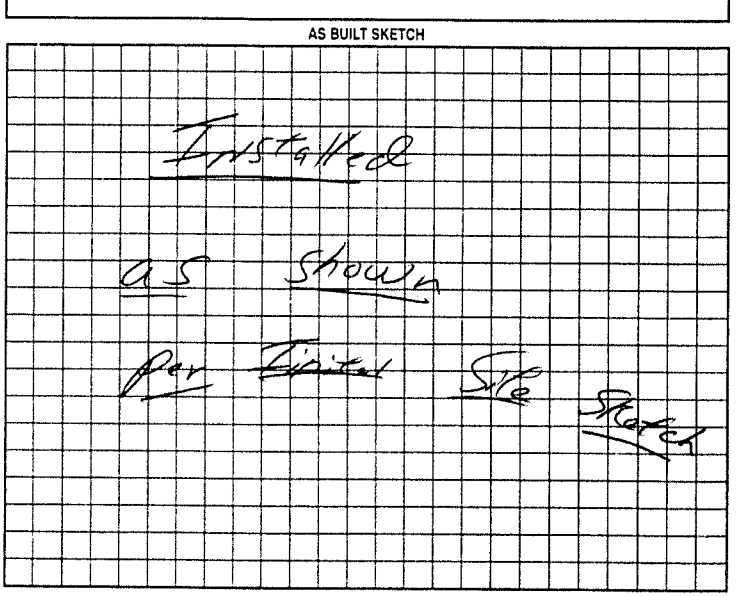

Permit can be suspended or revoked if any false information is supplied toward securing the permit/any unauthorized changes are made to the site/any unauthorized changes are made in the installation of the system. Improvement Permit with plat valid without expiration. Improvement Permit with site plan valid for sixty months. Authorization to Construct is valid for a period equal to that of Improvement Permit – not to exceed sixty months.

Signed: Sabrina Strand date 7-18-01 Installed by: Gaither Grading

Improvement Permit by: William O. Johnson date 7/17/01 Operation Permit by: William O. Johnson date 8/1/01

Authorization to Construct by: William O. Johnson date 7/17/01 Existing System Inspection by: — date —

HEALTH DEPT COPY WHITE OWNER COPY (FINAL) YELLOW OWNER COPY (INITIAL) PINK