IREDELL COUNTY HEALTH DEPARTMENT

STATESVILLE 704-878-5305 MOORESVILLE 704-664-5281

IMPROVEMENT PERMIT / AUTHORIZATION TO CONSTRUCT / OPERATION PERMIT / EXISTING SYSTEM INSPECTION

PERMIT# 109556 PIN# 4713-57-6017 DATE 10/31/02

OWNER OR CONTRACTOR JAMES SCOTT WINGLER PHONE: Business Home 704-872-6317

ADDRESS 178 HAPPY LN STATESVILLE, NC 28677

LOCATION HWY 70 WEST, (L) BETHLEHAM RD, (R) HAPPY LN, @ END OF CUL-DE-SAC, RIGHT DRIVE, DOWN HILL CROSS CREEK & UP.

SUBDIVISION — BLOCK / SECTION — LOT — LOT AREA 1.651 ACRES SITE CLASS PS DESIGN FLOW 360 GPD L.T.A.R. 0.325 GPD/FT2

Septic Tank: 1,000 Gallons; STB 1012 Date 08/17/02
Pump Tank: Gallons; PT Date
Pump Make: Model Serial No.
Nitrification Field: No Fields 1 Square Feet 1,108 Linear Feet 370
No Lines 4 Trench Width 36" Max Trench Bottom Depth 36"

[X] New System [ ] Repair System Type: I (II) III, IV, V, VI
System Description: CONVENTIONAL, GRAVITY
Repair System Description: SAME
Maintenance Agreement Required: [ ] Yes [X] No
Gravel Depth 12" [ ] Slab [ ] Crawl Space [ ] Basement w/plumbing [ ] Basement wo/plumbing


[X] House/Mod. Home No. Bedrooms 3
[ ] Mobile Home No. Bathrooms 2
[ ] Business No. Employees
[ ] Other

Water Supply: [X] Individual [ ] Public [ ] Community
WELL

Comments/Conditions: (1) MAINTAIN ALL SETBACKS, (2) INSTALL LINES ON CONTOUR.

Comments/Conditions:

INITIAL SITE SKETCH

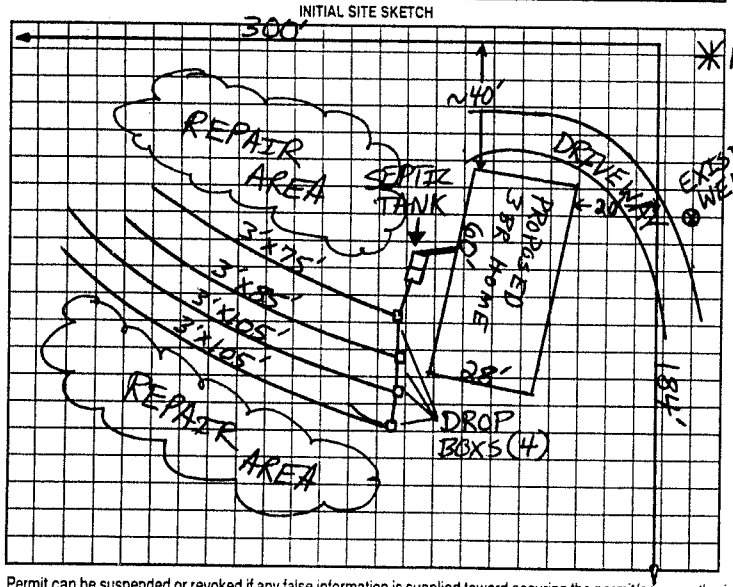

AS BUILT SKETCH

*NOT TO SCALE
~1"=40'

*SYSTEM INSTALLED AS SHOWN IN INITIAL SITE SKETCH

Permit can be suspended or revoked if any false information is supplied toward securing the permit/any unauthorized changes are made to the site/any unauthorized changes are made in the installation of the system. Improvement Permit with plat valid without expiration. Improvement Permit with site plan valid for sixty months. Authorization to Construct is valid for a period equal to that of Improvement Permit – not to exceed sixty months.

Signed: James Scott Wingler date 10/31/02 Installed by: DALE WINGLER

Improvement Permit by: Patrick Mitchell date 10/31/02 Operation Permit by: Patrick Mitchell date 12/18/02

Authorization to Construct by: Patrick Mitchell date 10/31/02 Existing System Inspection by: date

HEALTH DEPT. COPY: WHITE OWNER COPY (FINAL): YELLOW OWNER COPY (INITIAL): PINK