IREDELL COUNTY HEALTH DEPARTMENT

STATESVILLE 704-878-5305 MOORESVILLE 704-664-5281

IMPROVEMENT PERMIT / AUTHORIZATION TO CONSTRUCT / OPERATION PERMIT / EXISTING SYSTEM INSPECTION

PERMIT# 88001 PIN# 4718357626 DATE March 8 2000

OWNER OR CONTRACTOR Edward Wingler PHONE: Business 873-0472 Home

ADDRESS 165 Celesta Ext. Rd Statesville

LOCATION Hwy 70 W @ Bethlehem (R) Happy Lane To end of hill

SUBDIVISION Garden Park BLOCK / SECTION LOT 8 LOT AREA 4.51 Ac SITE CLASS PS DESIGN FLOW 240 L.T.A.R. 3

Septic Tank: 1000 Gallons; STB Date 2-1-2000
Pump Tank: Gallons; PT Date
Pump Make: Model Serial No.
Nitrification Field: No Fields 1 Square Feet 800 Linear Feet 270
No Lines 3 Trench Width 36" Max Trench Bottom Depth 36" Gravel Depth 12"

☑ New System ☐ Repair System Type: ☐ I ☑ III, IV, V, VI
System Description: Conv Gravity
Repair System Description: Same
Maintenance Agreement Required: ☐ Yes ☑ No

☐ House/Mod. Home No. Bedrooms 2
☑ Mobile Home SW No. Bathrooms 2
☐ Business No. Employees
☐ Other


☐ Slab ☑ Crawl Space ☐ Basement w/plumbing ☐ Basement wo/plumbing

Water Supply: ☑ Individual ☐ Public ☐ Community
well

Comments/Conditions: MAY Relocate Tank An Boxes To Left end of home if needed. Follow Set backs Rules


Not To Scale

INITIAL SITE SKETCH

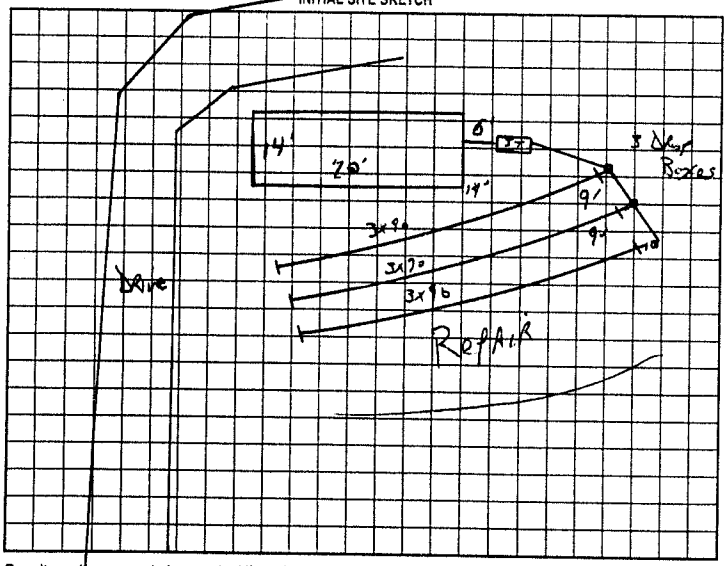

Comments/Conditions: 1st 2 Line ~~that~~ is Stalled As Shown 3-27-2000
3rd Line

AS BUILT SKETCH

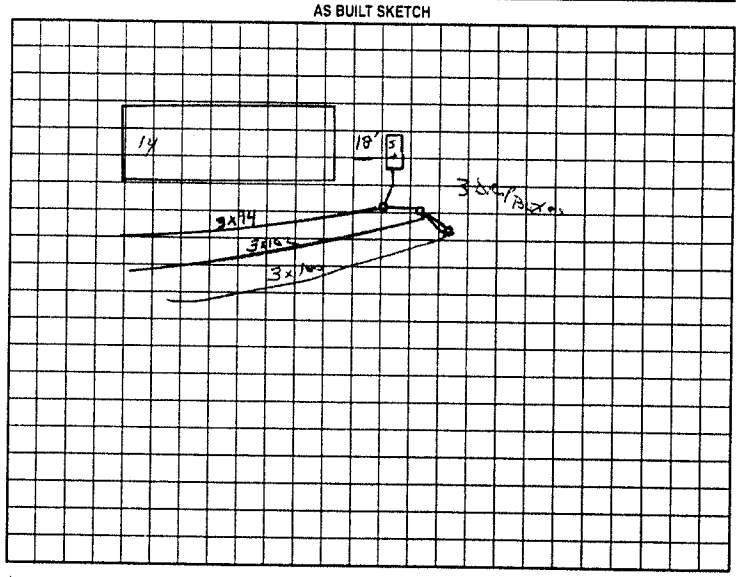

Permit can be suspended or revoked if any false information is supplied toward securing the permit/any unauthorized changes are made to the site/any unauthorized changes are made in the installation of the system. Improvement Permit with plat valid without expiration. Improvement Permit with site plan valid for sixty months. Authorization to Construct is valid for a period equal to that of Improvement Permit – not to exceed sixty months.

Signed: Dale Wingler date Installed by: Dale Wingler

Improvement Permit by: Jc Potter date March 8 2000 Operation Permit by: Jc Potter date March 28 2000

Authorization to Construct by: Jc Potter date March 8 2000 Existing System Inspection by: date

HEALTH DEPT. COPY: WHITE OWNER COPY (FINAL): YELLOW OWNER COPY (INITIAL): PINK