Owner

CF

IREDELL COUNTY HEALTH DEPARTMENT

STATESVILLE 704-878-5305 MOORESVILLE 704-664-5281

IMPROVEMENT PERMIT / AUTHORIZATION TO CONSTRUCT / OPERATION PERMIT / EXISTING SYSTEM INSPECTION

PERMIT# 134892 PIN# 4713-62-1205 DATE 11-16-06

OWNER OR APPLICANT Premier Developers PHONE: Business 704-948-6466 Home

ADDRESS 9815 J SAM FURR RD SUITE 231 Huntersville NC 28078

LOCATION 40 WEST (L) 6.MR (R) Angel OAKS (R) 6ANGEL LEAF AT END

SUBDIVISION Angel OAKS BLOCK / SECTION LOT 15 LOT AREA .68+ 1.173AC SITE CLASS. PS DESIGN FLOW 360 L.T.A.R. .25

Septic Tank: 1000 Gallons; STB 794 Date 9-25-06
Pump Tank: 1000 Gallons; PT 57 Date 11-6-06
Pump Make: GOULDS Model WE1512HT Serial No.
Nitrification Field: No Fields 1 Square Feet ER=1440 Linear Feet 360'
No Lines 4x90' Trench Width 36" Max Trench Bottom Depth 33"

☒ New System ☐ Repair ☐ Expansion System Type: I II (III) IV V VI
System Description: Pump 25+/- about
Repair System Description: LP 50'11
Maintenance Agreement Required: ☐ Yes ☒ No

☒ House/Mod. Home ☐ Mobile Home ☐ Business ☐ Other
No. Bedrooms 3 No. Persons 6 No. Employees


Water Supply: ☐ Individual ☒ Public ☐ Community

Gravel Depth N/A ☐ Gravity ☒ Pressure ☐ Slab ☒ Crawl Space ☐ Basement w/plumbing ☐ Basement wo/plumbing


Comments:/Conditions:
(1) House Built, OFFSITE SURVEYED & P/L STAKED.
(2) INSTALL LEVES ON CONTOURS MAINTAIN SETBACKS
(3) Supply Lines Installed Previously By Developer
(4) Note MAXimum TRENCH BOTTOM DEPTH OF 33"

Comments:/Conditions:
(5) THIS PERMIT Replaces Previously EXPIRED PERMIT
1st Visit TURNED DOWN First LINE, GAP BETWEEN CHAMBERS & TOO 5" TALL IN 20' SECTION. Revisited & PBLM FIXED.

INITIAL SITE SKETCH 1" = 100'

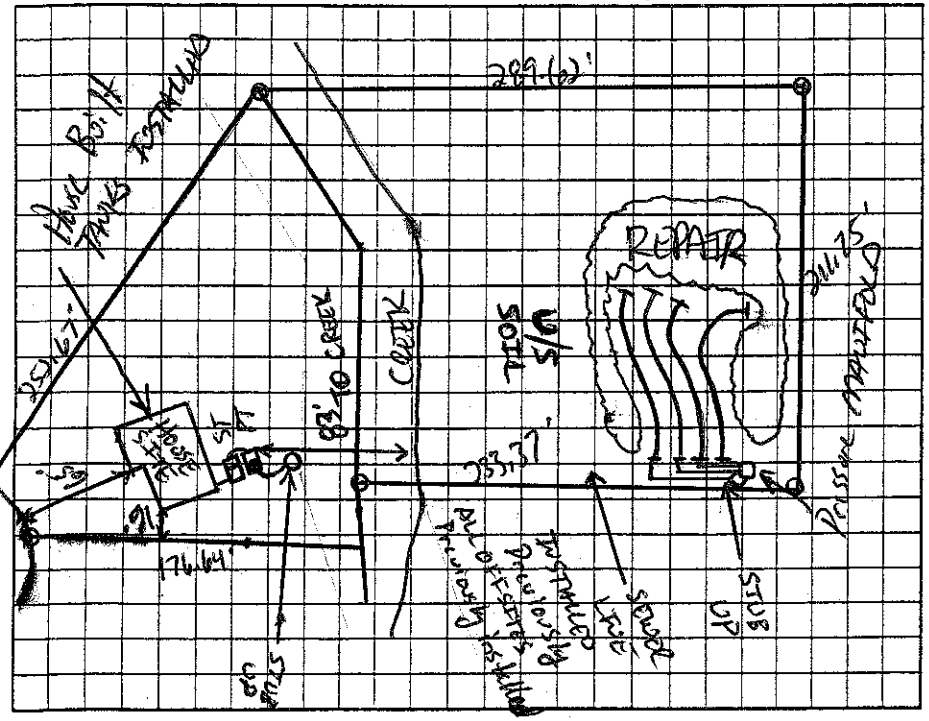

AS BUILT SKETCH

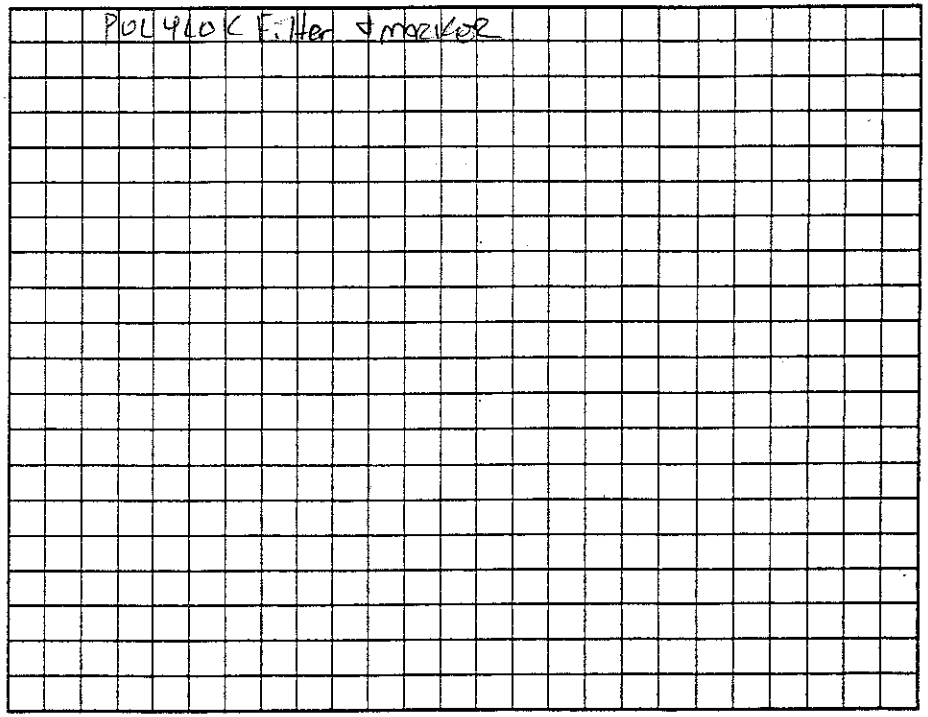

Permit can be suspended or revoked if any false information is supplied toward securing the permit/any unauthorized changes are made to the site/any unauthorized changes are made in the installation of the system. Improvement Permit with plat valid without expiration ☐ Improvement Permit with site plan valid for sixty months ☒ Authorization to Construct is valid for a period equal to that of Improvement Permit – not to exceed sixty months.

Signed: _____ date 11/17/06 Installed by: MARTY TUCKER

Improvement Permit by: _____ date 11-16-06 Operation Permit by: _____ date 12-12-06

Authorization to Construct by: _____ date 11-16-06 Existing System Inspection by: _____ date _____

HEALTH DEPT. COPY: WHITE OWNER COPY (FINAL): YELLOW OWNER COPY (INITIAL): PINK