IREDELL COUNTY HEALTH DEPARTMENT

STATESVILLE 704-878-5305 cI MOORESVILLE 704-664-5281

IMPROVEMENT PERMIT / AUTHORIZATION TO CONSTRUCT / OPERATION PERMIT / EXISTING SYSTEM INSPECTION

PERMIT# 089297 PIN# ~~4713632148 (Lot)~~ 4713-62-2231 DATE Jan. 26, 01

OWNER OR CONTRACTOR Earl Garrick PHONE: Business 324-9780 Home

ADDRESS 9815 J. Sam Furr Rd. Huntersville N.C. 28078

LOCATION From Trantman Old Whw. Rd. TL Angel Oaks Drive TR Green Leaf Ct. on left in cul-d-sac

SUBDIVISION Angel Oaks BLOCK / SECTION LOT 14 LOT AREA .076 ac SITE CLASS. B DESIGN FLOW 360gpd L.T.A.R. N, 225

Septic Tank: 1000 Gallons; STB 1007 Date 3-30-04

Pump Tank: Gallons; PT Date

Pump Make: Model Serial No.

Nitrification Field: No Fields 1 Square Feet 1200 Linear Feet 400

No Lines 4 Trench Width 36" Max Trench Bottom Depth 24" Gravel Depth N/A

☑ New System ☐ Repair System Type: I, II, III, IV, V, VI

System Description: Gravity Innovative 25% Red.

Repair System Description: Same

Maintenance Agreement Required: ☐ Yes ☑ No

☑ House/Mod. Home No. Bedrooms 3

☐ Mobile Home No. Bathrooms 2

☐ Business No. Employees

☐ Other


☐ Slab ☑ Crawl Space ☐ Basement w/plumbing ☐ Basement wo/plumbing

Water Supply: ☐ Individual ~~☑ Public~~ ☐ Community

Comments:/Conditions: 227.70'


INITIAL SITE SKETCH

1"=50'

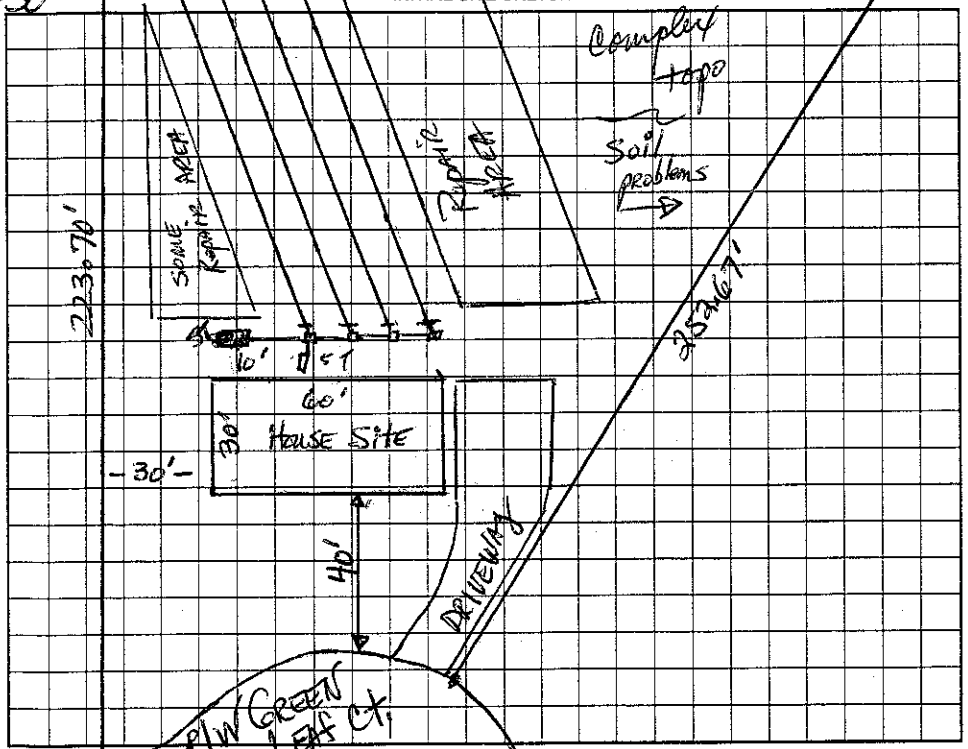

Comments:/Conditions: APPROVED 63'x31' PLAN. BUILDER OK'S STUBBING OUT THRU GARAGE. HOUSE WILL STILL BE 40' OFF FRONT LINE & 30' OFF SIDE LINE. THE HOUSE WILL ENCROACH INTO DRAWN DRIVEWAY

AS BUILT SKETCH

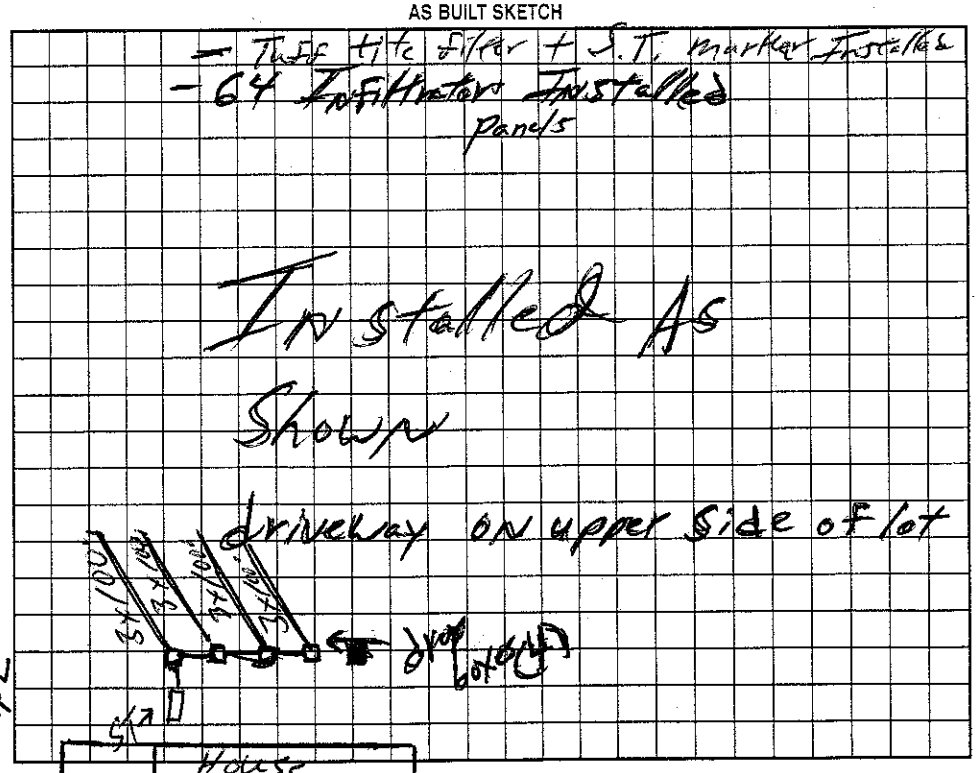

Permit can be suspended or revoked if any false information is supplied toward securing the permit/any unauthorized changes are made to the site/any unauthorized changes are made in the installation of the system. Improvement Permit with plat valid without expiration. Improvement Permit with site plan valid for sixty months. Authorization to Construct is valid for a period equal to that of Improvement Permit – not to exceed sixty months.

Signed: date

Improvement Permit by: date Jan 26, 01

Authorization to Construct by: date 3-10-04

Installed by: Sammy Shoemaker

Operation Permit by: William O. Johnson date 4/30/04

Existing System Inspection by: date

HEALTH DEPT. COPY: WHITE OWNER COPY (FINAL): YELLOW OWNER COPY (INITIAL): PINK