IREDELL COUNTY HEALTH DEPARTMENT

STATESVILLE 704-878-5305 MOORESVILLE 704-664-5281

IMPROVEMENT PERMIT / AUTHORIZATION TO CONSTRUCT / OPERATION PERMIT / EXISTING SYSTEM INSPECTION

PERMIT# ~~089340~~ 12392 PIN# ~~4713632148 (pt.)~~ 4713-62-2547 DATE Jan. 29, 01

OWNER OR CONTRACTOR EARL GARRICK PHONE: Business 374-9700 Home

ADDRESS 9815 J Sam Furr Rd. Huntersville NC 28078

LOCATION From Trantman Old Mtn Rd. TL Angel Oaks Drive TR Morningstar ct on left in cul-d-sac

SUBDIVISION Angel OAKS BLOCK / SECTION LOT 19 LOT AREA .49 ac SITE CLASS PS DESIGN FLOW 360 gpd L.T.A.R. .25-.3

Septic Tank: 1000 Gallons; STB for 7 Date 10-6-04
Pump Tank: Gallons; PT Date
Pump Make: Model Serial No.
Nitrification Field: No Fields 1 Square Feet 960 Linear Feet 320
No Lines 4 Trench Width 36" Max Trench Bottom Depth 36" Gravel Depth NA

☑ New System ☐ Repair System Type: I, II, III, IV, V, VI
System Description: Gravity Innovative-25% Red.
Repair System Description: SAME
Maintenance Agreement Required: ☐ Yes ☑ No

☑ House/Mod. Home No. Bedrooms 3
☐ Mobile Home No. Bathrooms 2
☐ Business No. Employees
☐ Other


☐ Slab ☑ Crawl Space ☐ Basement w/plumbing ☐ Basement wo/plumbing

Water Supply: ☐ Individual ☑ Public ☐ Community


Comments:/Conditions: INSTALL LATERALS AT 36" TRENCH BOTTOM DEPTH.
① - SEE ATTACHED SITE PLAN DATED APRIL 27, 2004
② - CONTACT HEALTH DEPT. AFTER CLEARING SITE TO FLAG OUT SYSTEM.

Comments:/Conditions: TUFFTITE FILTER & MARKER

INITIAL SITE SKETCH

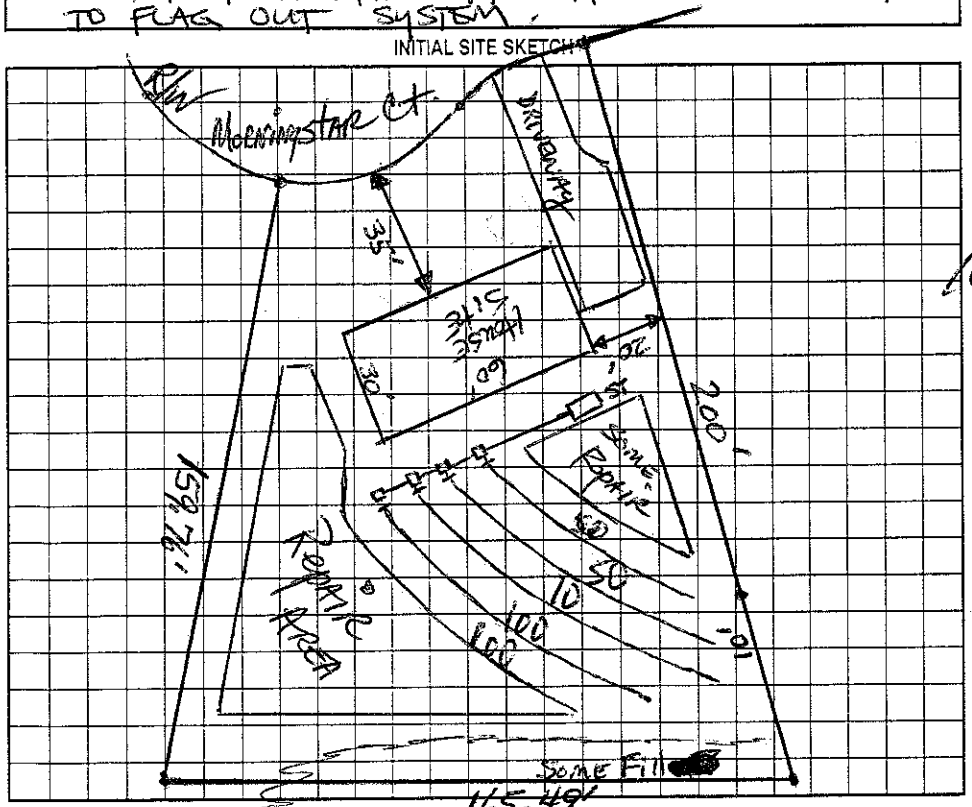

AS BUILT SKETCH

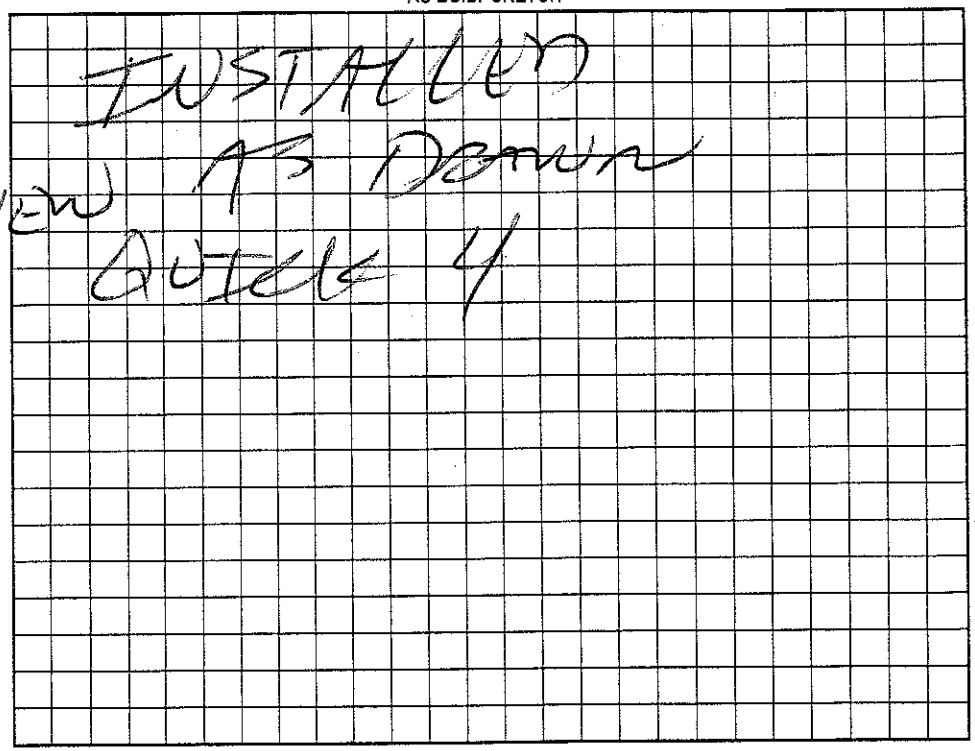

Permit can be suspended or revoked if any ~~false information is supplied toward securing~~ the permit/any unauthorized changes are made to the site/any unauthorized changes are made in the installation of the system. Improvement Permit with plat valid without expiration. Improvement Permit with site plan valid for sixty months. Authorization to Construct is valid for a period equal to that of Improvement Permit – not to exceed sixty months.

Signed: date Installed by: SAM 4 SHUMAKE

Improvement Permit by: date 1-29-01 Operation Permit by: date 12-15-04

Authorization to Construct by: STEVE HEDRICK date 4-29-04 Existing System Inspection by: date

HEALTH DEPT. COPY: WHITE OWNER COPY (FINAL): YELLOW OWNER COPY (INITIAL): PINK