IREDELL COUNTY HEALTH DEPARTMENT

STATESVILLE 704-878-5305 (C1) MOORESVILLE 704-664-5281

IMPROVEMENT PERMIT / AUTHORIZATION TO CONSTRUCT / OPERATION PERMIT / EXISTING SYSTEM INSPECTION

PERMIT# ~~089337~~ 130203 PIN# ~~4736321848 (pt.)~~ 4713-62-2847 DATE Jan 29,01

OWNER OR CONTRACTOR EARL GARRICK PHONE: Business 374-9700 Home

ADDRESS 9615 I Sam Furr RD. Huntersville N.C. 28078

LOCATION From Ironcutman Old Mtn Rd. TL Angel Oaks DRIVE TR Morningstar Ct. on Right in cul-d-sac

SUBDIVISION Angel Oaks BLOCK / SECTION LOT 22 LOT AREA 1.51Ac SITE CLASS. PS DESIGN FLOW 360gpd L.T.A.R. .03

Septic Tank: 1000 Gallons; STB Date

Pump Tank: Gallons; PT Date

Pump Make: Model Serial No. 300

Nitrification Field: ~~No Fields~~ 1 Square Feet 1200 Linear Feet 400

No Lines 4 3 Trench Width 36" Max Trench Bottom Depth 36" Gravel Depth 12"

☑ New System ☐ Repair ~~☑ System~~ RED System Type: I II III IV V VI

System Description: ~~GRAVITY~~ CONVENTIONAL

Repair System Description: SAME

Maintenance Agreement Required: ☐ Yes ☑ No

☑ House/Mod. Home No. Bedrooms 3

☐ Mobile Home No. Bathrooms 2

☐ Business No. Employees

☐ Other


☐ Slab ☑ Crawl Space ☐ Basement w/plumbing ☐ Basement wo/plumbing

Water Supply: ☐ Individual ☑ Public ☐ Community

Comments:/Conditions: 299.76' 1"=50'

Comments:/Conditions: Approved 3 BEDROOM HOUSE PLAN, BACK OF HOUSE IS IN SAME LOCATION.

INITIAL SITE SKETCH

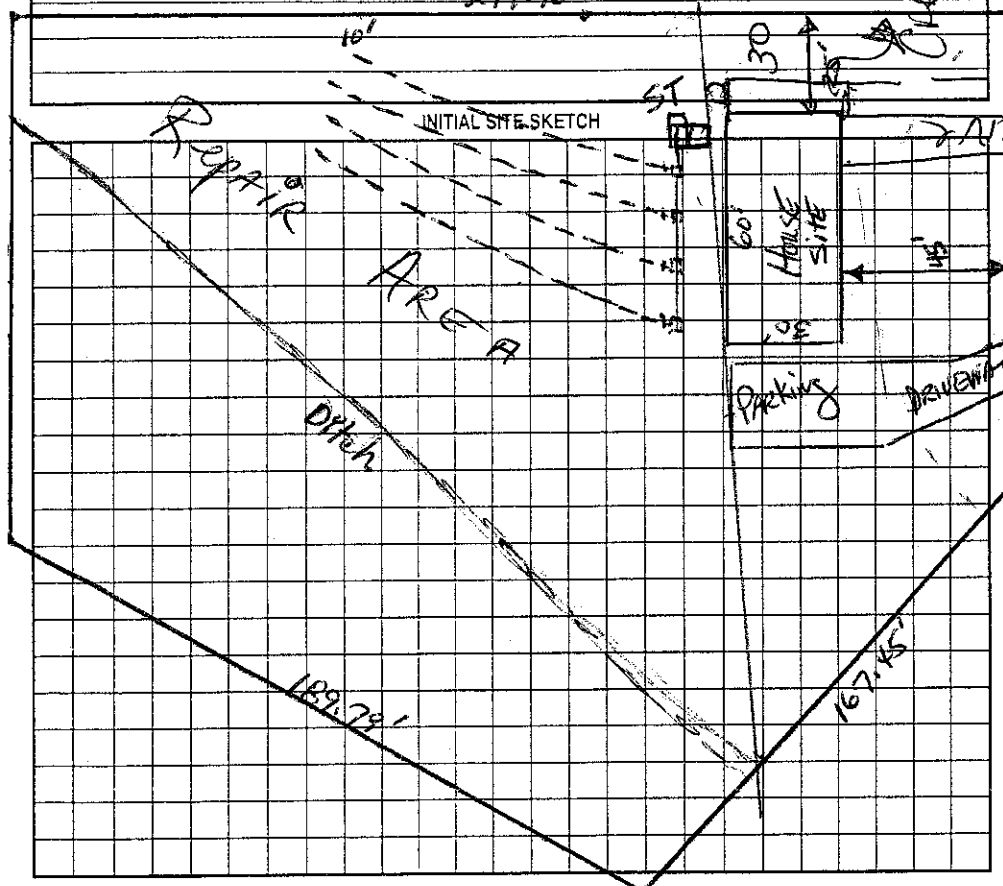

AS BUILT SKETCH

AN "ACCEPTED" SYSTEM WAS INSTALLED USING 75 "QUICK-4" INFILTRATOR CHAMBERS IN THREE LINES

The proposed Carport addition does not appear to impact the existing septic system.

**NOTE: CARPORT @ 30 → WIDER DRIVE R.S.

Date: 5-19-09

ICHD-Environmental Health Division

Permit can be suspended or revoked if any false information is supplied toward securing the permit/any unauthorized changes are made to the site/any unauthorized changes are made in the installation of the system. Improvement Permit with plat valid without expiration. Improvement Permit with site plan valid for sixty months. Authorization to Construct is valid for a period equal to that of Improvement Permit – not to exceed sixty months.

Signed: date

Improvement Permit by: , RS date 1-29-01

Authorization to Construct by: , RS date 7-25-05

Installed by: TUCKERS HAULING & GRADING

Operation Permit by: STEVE HARPER date 1-17-06

Existing System Inspection by: date

HEALTH DEPT COPY: WHITE OWNER COPY (FINAL): YELLOW OWNER COPY (INITIAL): PINK