IREDELL COUNTY HEALTH DEPARTMENT

STATESVILLE 704-878-5305 MOORESVILLE 704-664-5281

IMPROVEMENT PERMIT / AUTHORIZATION TO CONSTRUCT / OPERATION PERMIT / EXISTING SYSTEM INSPECTION

CI

PERMIT# 089296 PIN# ~~4713632148 (pt)~~ 4713-62-3261 DATE Jan 25, 01

OWNER OR CONTRACTOR Earl Garrick PHONE: Business 374-9700 Home

ADDRESS 9815 J Sam Furr Rd. Huntersville N.C. 28078

LOCATION From Trantman Old & Mtn Rd TL Angel Oaks Drive TR Greenleaf Ct on left

SUBDIVISION Angel Oaks BLOCK / SECTION LOT 13 LOT AREA .55Ac SITE CLASS. PS DESIGN FLOW 360gpd L.T.A.R. .25

Septic Tank: 1000 Gallons; STB 1007 Date 3-17-04

Pump Tank: Gallons; PT Date

Pump Make: Model Serial No.

Nitrification Field: No Fields 1 Square Feet 1080 Linear Feet 360

No Lines 4@~90' Trench Width 36" Max Trench Bottom Depth 36" Gravel Depth NA

☑ New System ☐ Repair System Type: I, II, III, IV, V, VI

System Description: Gravity Innovative -25% Red.

Repair System Description: Gravelp Innovative or Penn Black

Maintenance Agreement Required: ☐ Yes ☑ No

☑ House/Mod. Home No. Bedrooms 3

☐ Mobile Home No. Bathrooms 2

☐ Business No. Employees

☐ Other


☐ Slab ☑ Crawl Space ☐ Basement w/plumbing ☐ Basement wo/plumbing

Water Supply: ☐ Individual ☐ ~~Public~~ ☐ Community


Comments:/Conditions:

Comments:/Conditions: APPROVED 47'x32' HOME, DOTTED IN HOME ON PERMIT. KEEP STUBOUT 12" ABOVE NATURAL GRADE TO KEEP FALL TO TANK. MADE SITE VISIT & WILL WORK (LC) IF ABOVE CONDITIONS ARE KEPT.

INITIAL SITE SKETCH

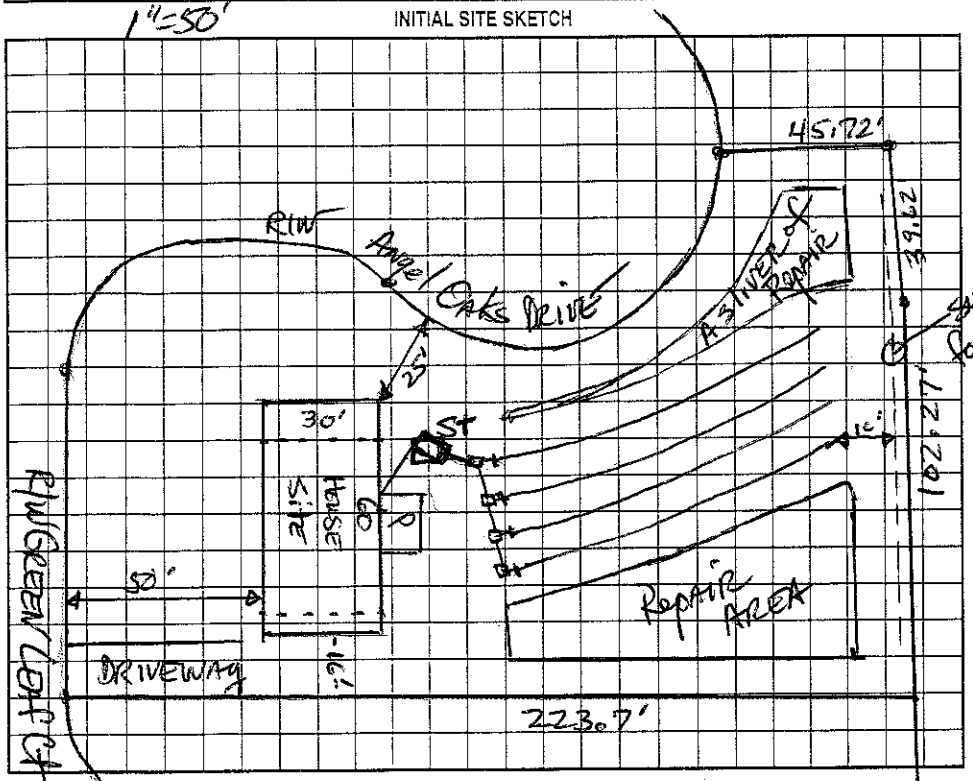

AS BUILT SKETCH

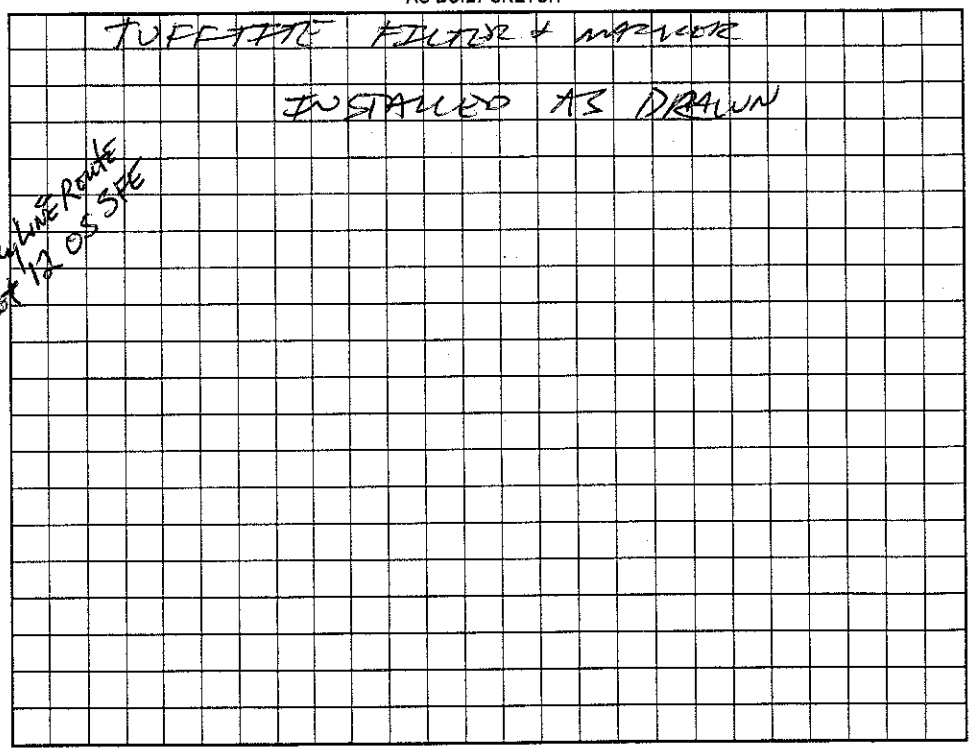

Permit can be suspended or revoked if any false information is supplied toward securing the permit/any unauthorized changes are made to the site/any unauthorized changes are made in the installation of the system. Improvement Permit with plat valid without expiration. Improvement Permit with site plan valid for sixty months. Authorization to Construct is valid for a period equal to that of Improvement Permit – not to exceed sixty months.

Signed: date

Improvement Permit by: IRS date 1-25-01

Authorization to Construct by: RS date 3-11-04

Installed by: IREDELL BACKHOE

Operation Permit by: RS date 4-29-04

Existing System Inspection by: date

HEALTH DEPT. COPY: WHITE OWNER COPY (FINAL): YELLOW OWNER COPY (INITIAL): PINK