IREDELL COUNTY HEALTH DEPARTMENT

STATESVILLE 704-878-5305 MOORESVILLE 704-664-5281

IMPROVEMENT PERMIT / AUTHORIZATION TO CONSTRUCT / OPERATION PERMIT / EXISTING SYSTEM INSPECTION

CI

PERMIT# ~~080342~~ / 23934 PIN# ~~4713632148 (Lt)~~ 23484 DATE May 16, 01

OWNER OR CONTRACTOR Earl Garrick PHONE: Business 374-9700 Home

ADDRESS 9815 I Sam Furr Rd. Huntersville N.C. 28078

LOCATION From Trantman Old Mtn Rd. TL, Angel Oaks Drive TR Green Leaf Ct 1st lot on Right

SUBDIVISION Angel Oaks BLOCK / SECTION LOT 17/17A LOT AREA .54Ac+.35Ac SITE CLASS PSSFE 17A DESIGN FLOW 360gpd L.T.A.R. ~.3

Septic Tank: 1000 Gallons; STB 1007 Date 10-7-04

Pump Tank: 1000 Gallons; PT 274 Date 10-7-04

Pump Make: Zoeller Model BN98-13 Serial No. -

Nitrification Field: No Fields 1 Square Feet 900 Linear Feet 300

No Lines 3 Trench Width 36" Max Trench Bottom Depth 36" Gravel Depth NA

☑ New System ☐ Repair System Type: I, II, III, IV, V, VI

System Description: PPM Innovative-25% Reduction

Repair System Description: LP Innovative or PPBAS

Maintenance Agreement Required: ☐ Yes ☑ No

☑ House/Mod. Home No. Bedrooms 3

☐ Mobile Home No. Bathrooms 2

☐ Business No. Employees

☐ Other

☐ Slab ☑ Crawl Space ☐ Basement w/plumbing ☐ Basement wo/plumbing


Water Supply: ☐ Individual ☑ Public ☐ Community

Comments:/Conditions:

Comments:/Conditions: 3 BEDROOM

APPROVED 50'x49' PLAN. MAINTAIN SETBACKS - 2 6cl filter + ST Marker Installed, Tanker okay 12/17/04

INITIAL SITE SKETCH

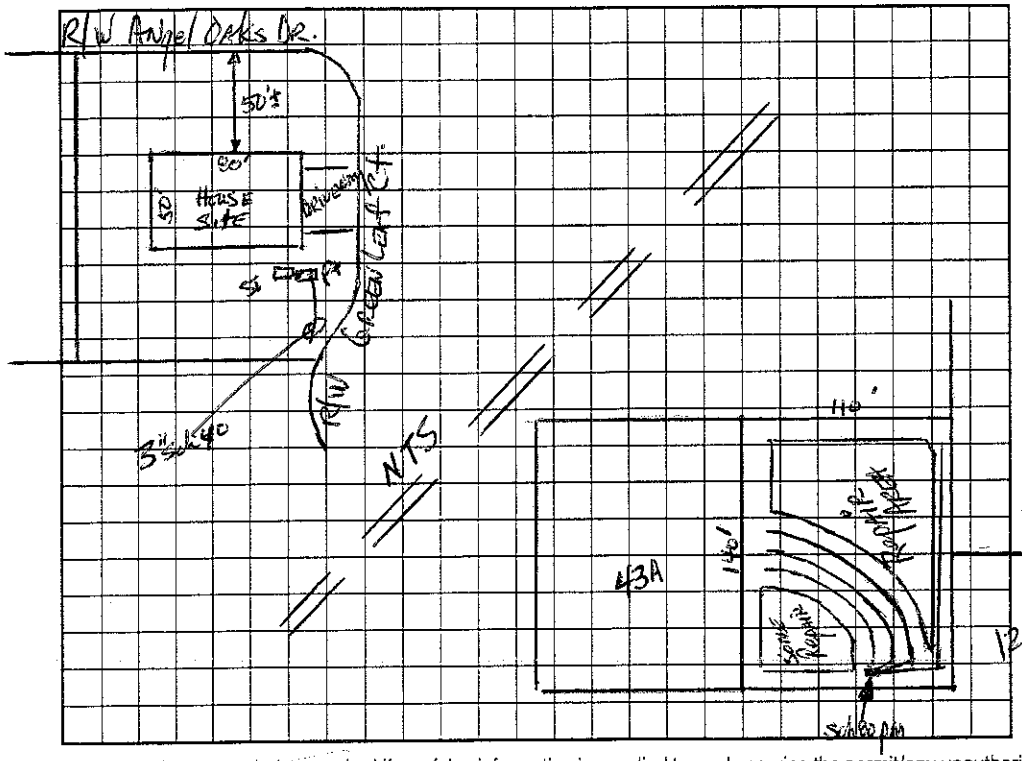

AS BUILT SKETCH

12-21-04 - V 'D LINES; OFFSITE SURVEYED OUT NEED ELECTRICAL HOOKUP

12-30-04 V PRESSURE LC

3-16-05 V ELECTRICAL HOOKUP NEEDS FLOATS HOOKED UP 3-16-05 V 'D FLOATS LC 3-16-05

Permit can be suspended or revoked if any false information is supplied toward securing the permit/any unauthorized changes are made to the site/any unauthorized changes are made in the installation of the system. Improvement Permit with plat valid without expiration. Improvement Permit with site plan valid for sixty months. Authorization to Construct is valid for a period equal to that of Improvement Permit – not to exceed sixty months.

Signed: date

Improvement Permit by: Mark R. Hinson, RS date 5-16-01

Authorization to Construct by: date 9-7-04

Installed by: Sammy Shoemaker

Operation Permit by: date 3-18-05

Existing System Inspection by: date

HEALTH DEPT. COPY: WHITE OWNER COPY (FINAL): YELLOW OWNER COPY (INITIAL): PINK