IREDELL COUNTY HEALTH DEPARTMENT

STATESVILLE 704-878-5305 MOORESVILLE 704-664-5281

IMPROVEMENT PERMIT / AUTHORIZATION TO CONSTRUCT / OPERATION PERMIT / EXISTING SYSTEM INSPECTION

PERMIT# 089336 PIN# ~~4713-62-32-48 (pt.)~~ 4713-62-4728 DATE Jan 29, 01

OWNER OR CONTRACTOR Earl Garrick PHONE: Business 374-9700 Home

ADDRESS 9815 J Sam Furr Rd. Huntersville N.C. 28078

LOCATION From Trotman Old Statesville Rd. TL Angel Oaks Drive TR Morningstar Ct. 1st lot on Right - corner lot

SUBDIVISION Angel Oaks BLOCK / SECTION LOT 23 LOT AREA .54 SITE CLASS. PS DESIGN FLOW 360gpd L.T.A.R. .25 - .3

Septic Tank: 1000 Gallons; STB 1007 Date 3-12-03
Pump Tank: Gallons; PT Date
Pump Make: Model Serial No.
Nitrification Field: No Fields 1 Square Feet 960 Linear Feet 320
No Lines 3 Trench Width 36" Trench Bottom Depth 36" Gravel Depth N/A

☑ New System ☐ Repair System Type: I II III IV V VI
System Description: Gravity Innovative - 25% Red
Repair System Description: Same
Maintenance Agreement Required: ☐ Yes ☐ No

☑ House/Mod. Home No. Bedrooms 3
☐ Mobile Home No. Bathrooms 2
☐ Business No. Employees
☐ Other
☐ Slab ☑ Crawl Space ☐ Basement w/plumbing ☐ Basement wo/plumbing


Water Supply: ☐ Individual ☑ Public ☐ Community

Comments:/Conditions: Install Laterals at 36" trench bottom depth.

Comments:/Conditions: TUFF TITE FILTER & MARKER
SUPPLY LINE IS 7' OFF P/L & D/L IS 10' OFF P/L. END OF LINES IS 15' OFF CUT BANK.

INITIAL SITE SKETCH

1"=50'

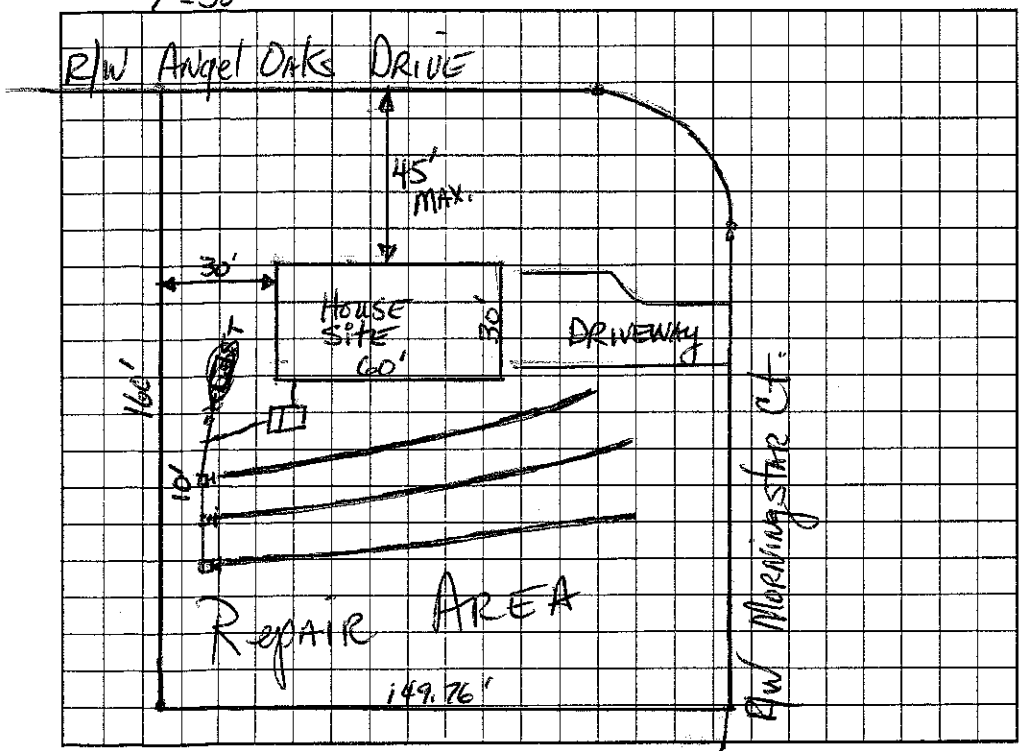

AS BUILT SKETCH

1ST LINE = 16 CHAMBERS
2ND LINE = 18 CHAMBERS
3RD LINE = 18 CHAMBERS

INSTALLED AS SHOWN.

Permit can be suspended or revoked if any false information is supplied toward securing the permit/any unauthorized changes are made to the site/any unauthorized changes are made in the installation of the system. Improvement Permit with plat valid without expiration. Improvement Permit with site plan valid for sixty months. Authorization to Construct is valid for a period equal to that of Improvement Permit – not to exceed sixty months.

Signed: date

Improvement Permit by: Mark Thomas PS date 1-29-01

Authorization to Construct by: Patricia Mitchell date 03/25/03

Installed by: FREDELL BACKHOE & SEPTIC

Operation Permit by: PS date 4-29-03

Existing System Inspection by: date

HEALTH DEPT. COPY: WHITE OWNER COPY (FINAL): YELLOW OWNER COPY (INITIAL): PINK