704-402-6878

IREDELL COUNTY HEALTH DEPARTMENT

STATESVILLE 704-878-5305 MOORESVILLE 704-664-5281

IMPROVEMENT PERMIT / AUTHORIZATION TO CONSTRUCT / OPERATION PERMIT / EXISTING SYSTEM INSPECTION

PERMIT# ~~00335~~ 19784 PIN# 4713632148(pt.) 4713-62-4943 DATE Jan 29 01

OWNER OR CONTRACTOR EARL GARRICK PHONE: Business 374-9700 Home

ADDRESS 9615 J Sam Furr Rd. Huntersville N.C. 28078

LOCATION From Trautman Old Mtn Rd. TL Angel Oaks Drive on left before jct w/ Morningstar Ct.

SUBDIVISION Angel Oaks BLOCK / SECTION LOT 24 LOT AREA .55 Ac SITE CLASS. BS DESIGN FLOW 360gpd L.T.A.R. .3±

Septic Tank: 1000 Gallons; STB 1007 Date 4-2-04
Pump Tank: Gallons; PT Date
Pump Make: Model Serial No.
Nitrification Field: No Fields 1 Square Feet 1200 Linear Feet 400
No Lines 4 Trench Width 36" Trench Bottom Depth 36" Gravel Depth 12"

☑ New System ☐ Repair System Type: I, II, III, IV, V, VI
System Description: Gravity Conventional
Repair System Description: ~~Gravity/pumped~~ Innovative -25%
Maintenance Agreement Required: ☐ Yes ☑ No Rel.
☐ Slab ☑ Crawl Space ☐ Basement w/plumbing ☐ Basement wo/plumbing

☑ House/Mod. Home No. Bedrooms 3
☐ Mobile Home No. Bathrooms 2
☐ Business No. Employees
☐ Other


Water Supply: ☐ Individual ☑ Public ☐ Community

Comments:/Conditions: INSTALL LATERALS AT 36" trench bottom depth.

Comments:/Conditions: APPROVED 50x31 PLAN 3 BEDROOM; PLAT IS ATTACHED TUFFLEX FILTER & MANIFOLD

INITIAL SITE SKETCH

1"=50'

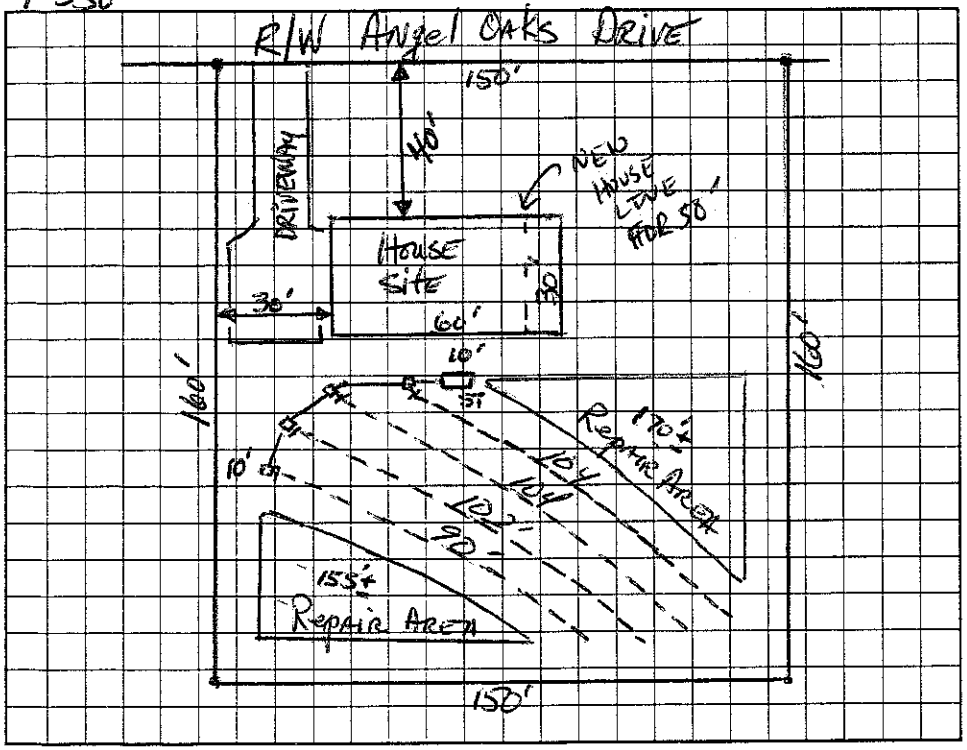

AS BUILT SKETCH

HOUSE NOT BUILT AT TIME OF CHECK, SYSTEM INSTALLED AS DRAWN.

Permit can be suspended or revoked if any false information is supplied toward securing the permit/any unauthorized changes are made to the site/any unauthorized changes are made in the installation of the system. Improvement Permit with plat valid without expiration. Improvement Permit with site plan valid for sixty months. Authorization to Construct is valid for a period equal to that of Improvement Permit – not to exceed sixty months.

Signed: date

Improvement Permit by: date 1-29-01

Authorization to Construct by: date 3-10-04

Installed by: Statesville Backhoe

Operation Permit by: date 5-17-04

Existing System Inspection by: date

HEALTH DEPT. COPY: WHITE OWNER COPY (FINAL): YELLOW OWNER COPY (INITIAL): PINK